

## FALL CREEK REGIONAL WASTE DISTRICT

9378 S 650 WEST, P.O. BOX 59, PENDLETON, IN 46064

765-778-7544

## AGREEMENT FOR SANITARY SEWER SERVICE

This Agreement made and entered into this 26<sup>th</sup> day of October, 2001, between FALL CREEK REGIONAL WASTE DISTRICT ("District") and Patrick Cunningham ("Applicant") regarding the provision of sanitary sewer service, and the assignment of capacity in, and connection to, the District's facilities for the premises located at 1008 York Drive.

NOW THEREFORE, the parties, in consideration of the mutual promises set out in this Agreement, the receipt and sufficiency of which is hereby acknowledged, agree as follows:

1. The Applicant agrees that all workmanship and materials shall conform to all District ordinances and the District's construction standards. District must accept and approve all work and materials before backfilling and final connection is made to the sewer mains. Any violation of this provision will cause all lines and appurtenances in violation to be removed and replaced at the Applicant's expense.

2. The District shall have the right to enter the property at all reasonable times to inspect, repair, or replace any equipment used in connection with the service or which has an impact on said service.

3. The Applicant shall be responsible for all charges, and tap fees. The failure to pay any rate charge or fee may result in the termination of service to the property, the cost of which will be borne by Applicant. The Applicant shall be responsible for all attorney's fees and collection costs.

4. The District shall not be responsible for any failure to supply service unless said damages are due to default, neglect or culpability on the part of the District.

5. If there is an available sanitary sewer within three hundred (300) feet of the property line, the property owner shall be required to connect to the District's sanitary sewer system.

6. The Applicant and District agree that the provision of sanitary sewer service touches and concerns the property and the terms of this Agreement bind the District and Applicant and their heirs, executors, administrators, personal representatives, successors, agents, attorneys, assigns, designees, and transferees.

The parties hereto have read and fully understand the above provisions and agree to comply with said provisions.

FALL CREEK REGIONAL WASTE DISTRICT

Signature

STATE OF INDIANA )

) SS:

COUNTY OF MADISON )

APPLICANT

Signature

SUBSCRIBED and sworn to before me this 26<sup>th</sup> day of October, 2001.

My Commission Expires:

4-29-2009

Signature

Printed

Notary Public

Resident of Madison County

\*\*\*\*\*  
INSPECTOR Steve DATE INSPECTED 11/7/01 APPROVED ☒ REJECTED ☐

REASON FOR REJECTION \_\_\_\_\_

DATE REINSPECTED \_\_\_\_\_ APPROVED \_\_\_\_\_ REJECTED \_\_\_\_\_

## NOTES:

SIZE PIPE 4" 1/2 TYPE PIPE SPR 35 160

BASEMENT YES ☐ NO ☒

SUMP PUMP YES ☐ NO ☒

DOWNSPOUT TO GROUND ☒ YES ☐ NO


SEPTIC TANK PUMPED & FILLED ☒ YES ☐ NO

CONTRACTOR Zeds Plumbing

SPECIAL CONDITIONS \_\_\_\_\_

EXISTING HOME ☒

NEW CONSTRUCTION ☐

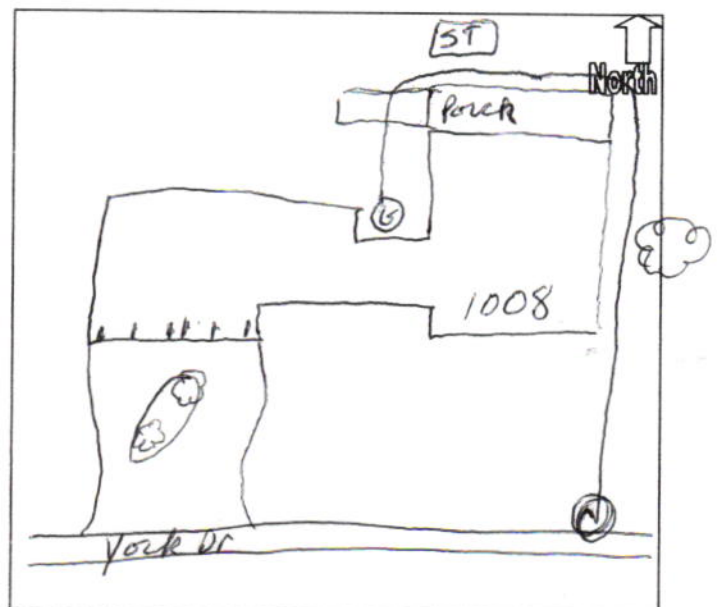

PATRICK J. CUNNINGHAM, JR.  
1008 YORK DR. PH. 765-778-0305  
PENDLETON, IN 46064

71-553/749  
2900262


1697

DATE 10-26-01

PAY TO THE  
ORDER OF

FCRWD

\$ 2,024.80

Two thousand twenty-four and  $\frac{80}{100}$  DOLLARS  Security Features  
Included  
Details on back



Madison  
Community Bank

MEMO SEWER

⑆074905539⑆

1697

MP

SAFETY PAPER