



FALL CREEK REGIONAL WASTE DISTRICT

Box 44, Pendleton, Indiana 46064

APPLICATION FOR SEWER PERMIT

Nº 000016

Permit No. _____ Date 7-30-85

Permit Void 90 days from Date of Issuance

Owner Name Paul MuellerProperty Address RR#2 Box ~~368~~ 324 BroadwayLot # _____ P.O. Box 1009 S. BroadwayTown Pendleton, IN Zip Code 46064-9560Phone 778-7295 Water Meter 5/8"\$ 150.00 Tap on Fee Paid\$ 25.00 Inspection fee paid

Application is hereby made for connection to the Fall Creek Regional Waste District Sewer System for the above listed property - Permit Type: Residential ☒, Commercial _____, Industrial _____, or Governmental/Institutional _____. User Information _____.

All workmanship and materials shall conform to the standards of the District Ordinance as described in Ordinance 84-2 and 84-3 as amended. Acceptance and approval must be made by the District inspector or his duly authorized representative before backfilling and final connection is made to the main sewer lines. Any violation of applicable regulations will cause all lines and appurtenances in violation to be removed and replaced at the owners expense.

The Fall Creek Regional Waste District is responsible for the inspection, approval of materials, and installation techniques only. All costs for materials and installation and any liabilities resulting from same is the sole responsibility of the property owner.

I have read and fully understand the above provisions and agree to comply by said provisions.


Paul R. Mueller
APPLICANT(S) SIGNATURE

INSPECTOR BenDate inspected 8-9-85 Approved ☒ Rejected _____

Reason for rejection _____

Date reinspected _____ Approved _____ Rejected _____

Notes:

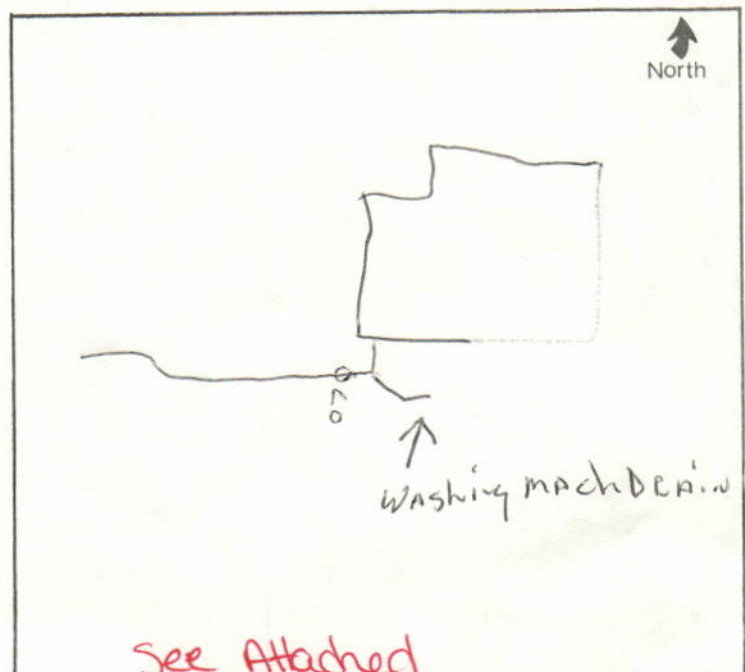Size Pipe 6"Type Pipe PVCBasement Yes _____ No ☒Sump Pump Yes _____ No ☒Downspout to Ground Yes ☒ No _____Septic Tank Pumped & filled Yes ☒ No _____Contractor Flat FordSpecial Conditions 3 downspoutsin ground to SEPERATE DRAIN
(TEST)

National Waterworks

617-8462

Indianapolis
(317) 271-1463
(800) 792-3461
Fax (317) 271-2026

Oaklandon
(317) 823-4474
Fax (317) 823-2363


Bloomington
(812) 331-0356
(800) 859-5999
Fax (812) 331-0371

"Local Service, Nationwide"

St. John
(219) 365-9995
(800) 771-9995
Fax (219) 365-9996

Steve Waterworks
324 Broadway
677107

IV →

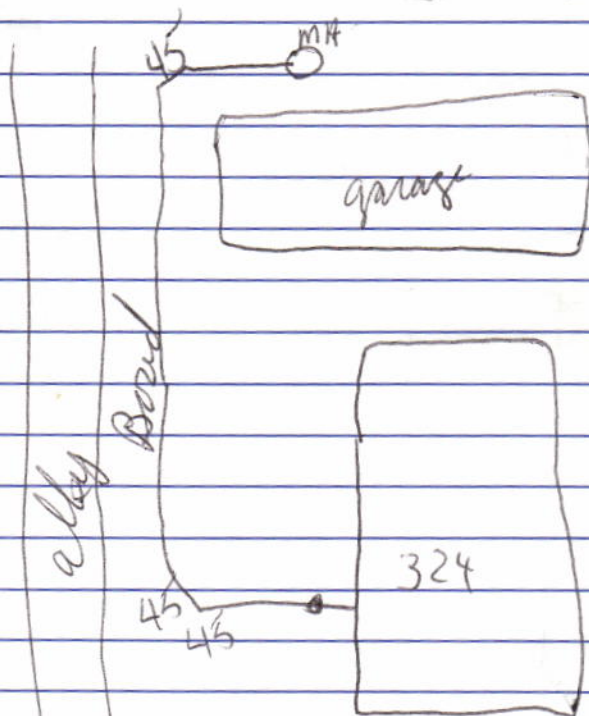

Broadway

Distributor of



Products