

Gidw.


PROJECT Phase II SHEET _____ OF _____

SUBJECT _____ DATE _____

JOB NO. 4447

BY AT/As

100 E. High

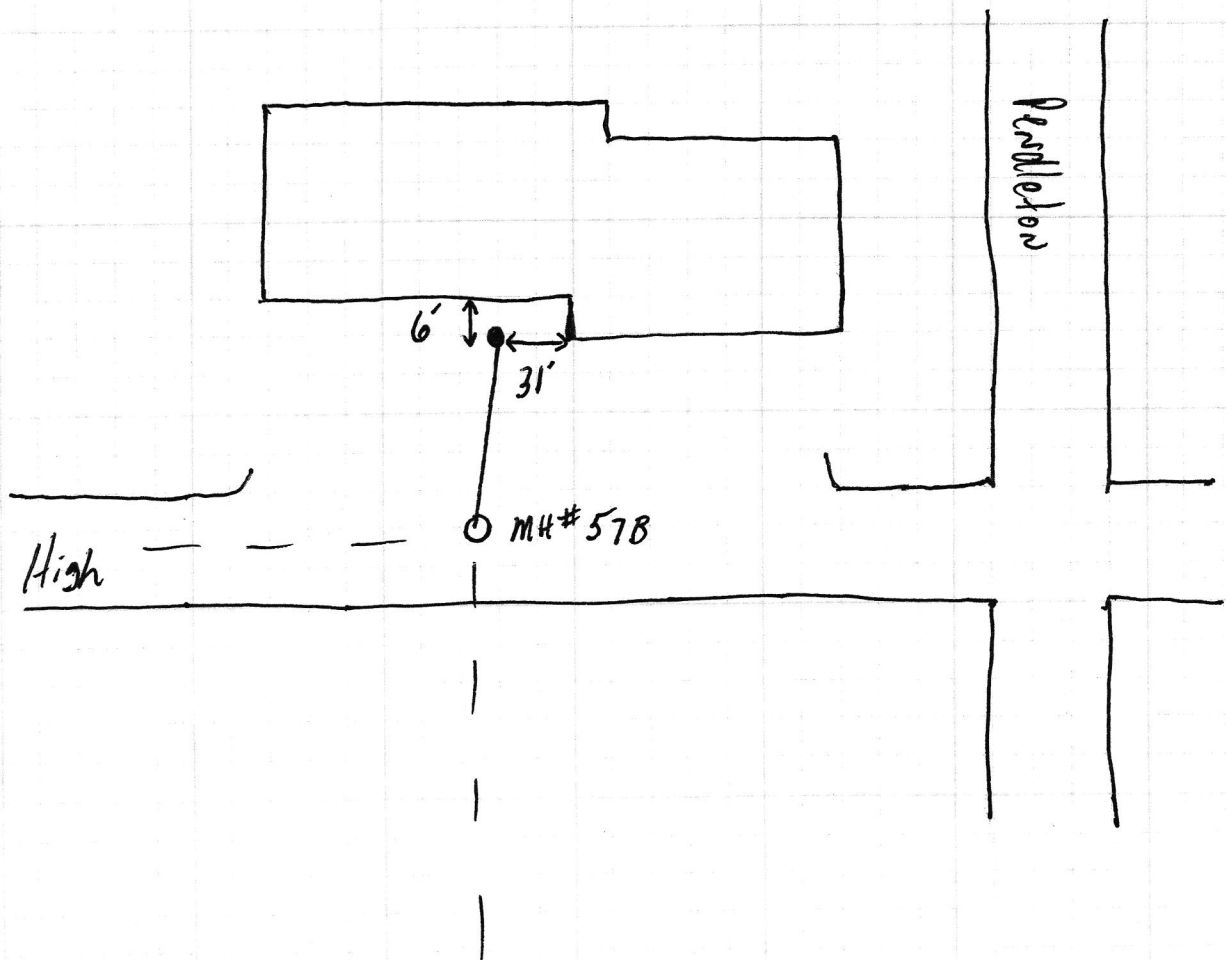

100 & High

SRP Phase II

