



FALL CREEK REGIONAL WASTE DISTRICT

9378 S. 650 West PO Box 59
Pendleton, IN 46064-0059 778-7544

8-18989.00

APPLICATION FOR SEWER PERMIT

Nº 2189

Date 4/19/95

Permit Void 90 days from Date of Issuance

Owner Name James Craig

Property Address 100 Fall Creek Parkway

Lot # _____ P.O. Box _____

Town Pendleton, IN Zip Code 46064

Phone _____ City Water ☒ Well _____

\$ 700.00 Tap on Fee Paid

\$ _____ Inspection fee paid

Application is hereby made for connection to the Fall Creek Regional Waste District Sewer System for the above listed property - Permit Type: Residential ☒, Commercial _____, Industrial _____, or Governmental/Institutional _____. User Information _____.

All workmanship and materials shall conform to the standards of the District Ordinance as described in Ordinance 84-2 and 84-3 as amended. Acceptance and approval must be made by the District inspector or his duly authorized representative before backfilling and final connection is made to the main sewer lines. Any violation of applicable regulations will cause all lines and appurtenances in violation to be removed and replaced at the owners expense.

The Fall Creek Regional Waste District is responsible for the inspection, approval of materials, and installation techniques only. All costs for materials and installation and any liabilities resulting from same is the sole responsibility of the property owner.

I have read and fully understand the above provisions and agree to comply by said provisions.

APPLICANT(S) SIGNATURE

*****B*****

INSPECTOR B

Date inspected 9-24-96 Approved ☒ Rejected _____

Reason for rejection _____

Date reinspected _____ Approved _____ Rejected _____

Notes:

Size Pipe 4"

Type Pipe PVC

Basement Yes ☒ No _____

Sump Pump Yes ☒ No _____

Downspout to Ground Yes ☒ No _____


Septic Tank Pumped & filled Yes ☒ No _____

Contractor Earl Davis

Special Conditions _____

Existing Home ☒

New Construction _____

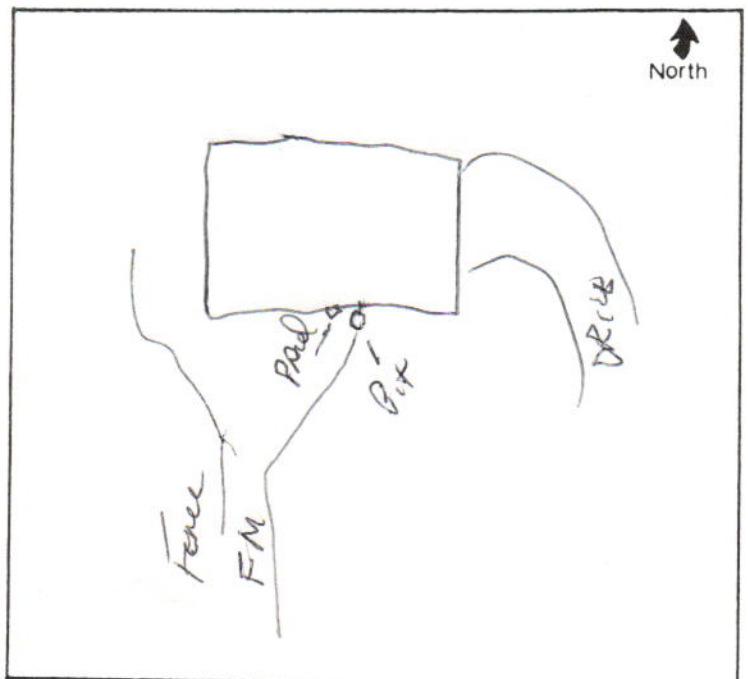



FALL CREEK REGIONAL WASTE DISTRICT

P.O. Box 59 • 9378 S. 650 West • Pendleton, Indiana 46064-0059 • (317) 778-7544

April 11, 1997

Mrs. Teresa Hutton
Office Manager

RE: Account #8-18989.00
Mr. Jim Craig
100 W. Fall Creek
Parkway
Pendleton, IN 46064

Dear Teresa:

It is my understanding from Mr. Earl Davis, the contractor that installed Mr. Craig's lateral and wastewater grinder unit, that in order to complete the installation of Mr. Craig's grinder unit, it was necessary to special order a needed part and that the part was back-ordered or misplaced at the supplier from March, 1995 until about August, 1996.

Mr. Davis indicates that this part was needed for the tie-in of the grinder unit to Mr. Craig's house line and that Mr. Craig was connected as soon as the part arrived.

Under these circumstances, it was impossible for Mr. Craig's residence to be connected to our system and become a FCRWD customer prior to August 1996. In view of this information, please adjust off the \$568.29 from Mr. Craig's account.

Thanks,

J. F. Rowlett
General Manager

RECEIPT

FALL CREEK REGIONAL WASTE DISTRICT

P.O. BOX 59, CO. RD. 650 WEST

No 4872

gen FUND

PENDLETON, IN. 46064, 4/19 1995

RECEIVED FROM James & Patricia Craig \$700.00

THE SUM OF Seven hundred & 00/100 DOLLARS

ON ACCOUNT OF tap fee

100 Fall Creek Parkway

PAID BY: CASH ☐ CHECK ☒ M.O. ☐ 9336

Robbie Wilson

AUTHORIZED SIGNATURE