

Gidw.


PROJECT Phase II SHEET _____ OF _____

SUBJECT _____ DATE 5-11-18

JOB NO. 4447

BY Atlas

100 W. State

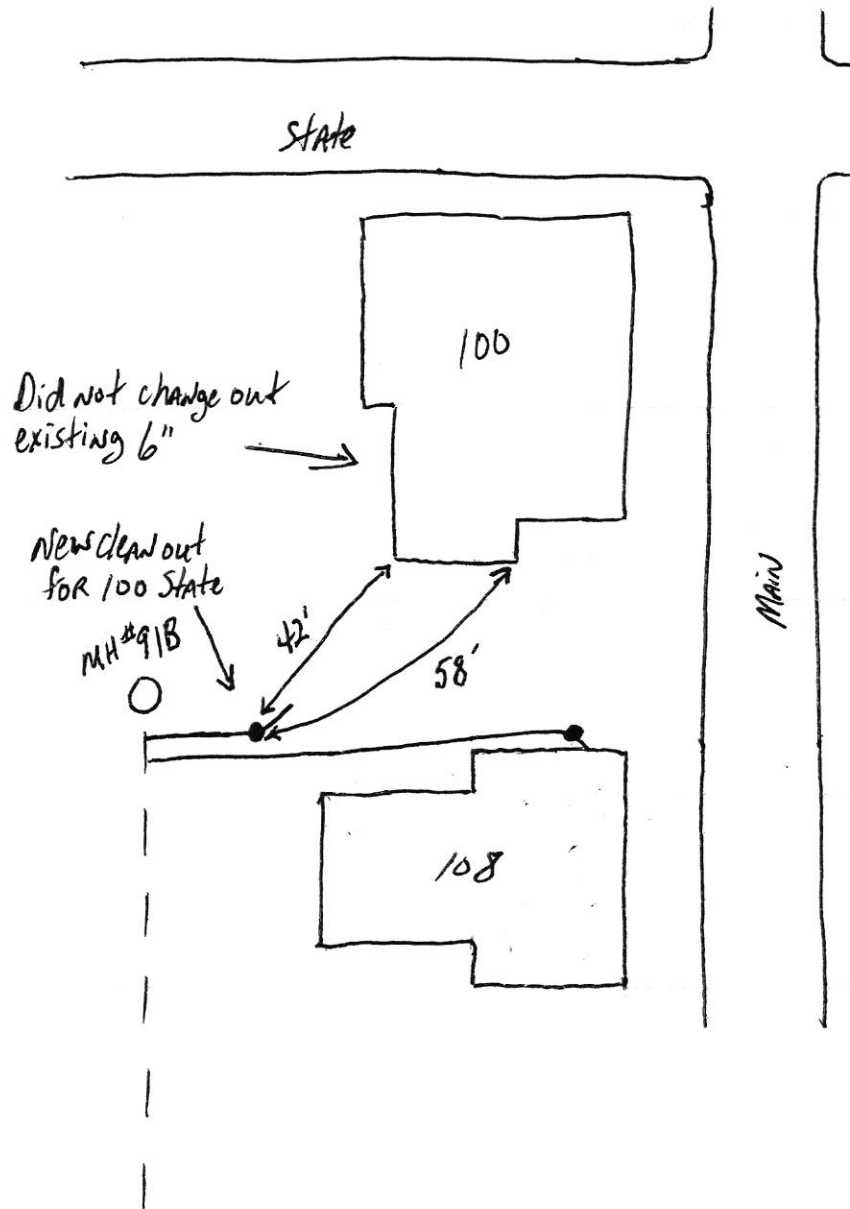



100 W. State

SPT Phase II

5.22.18