

*GISW.*

PROJECT

*Phase II*

SHEET


OF

SUBJECT

DATE *8-10-18*

JOB NO *4447*

BY *Atlas*

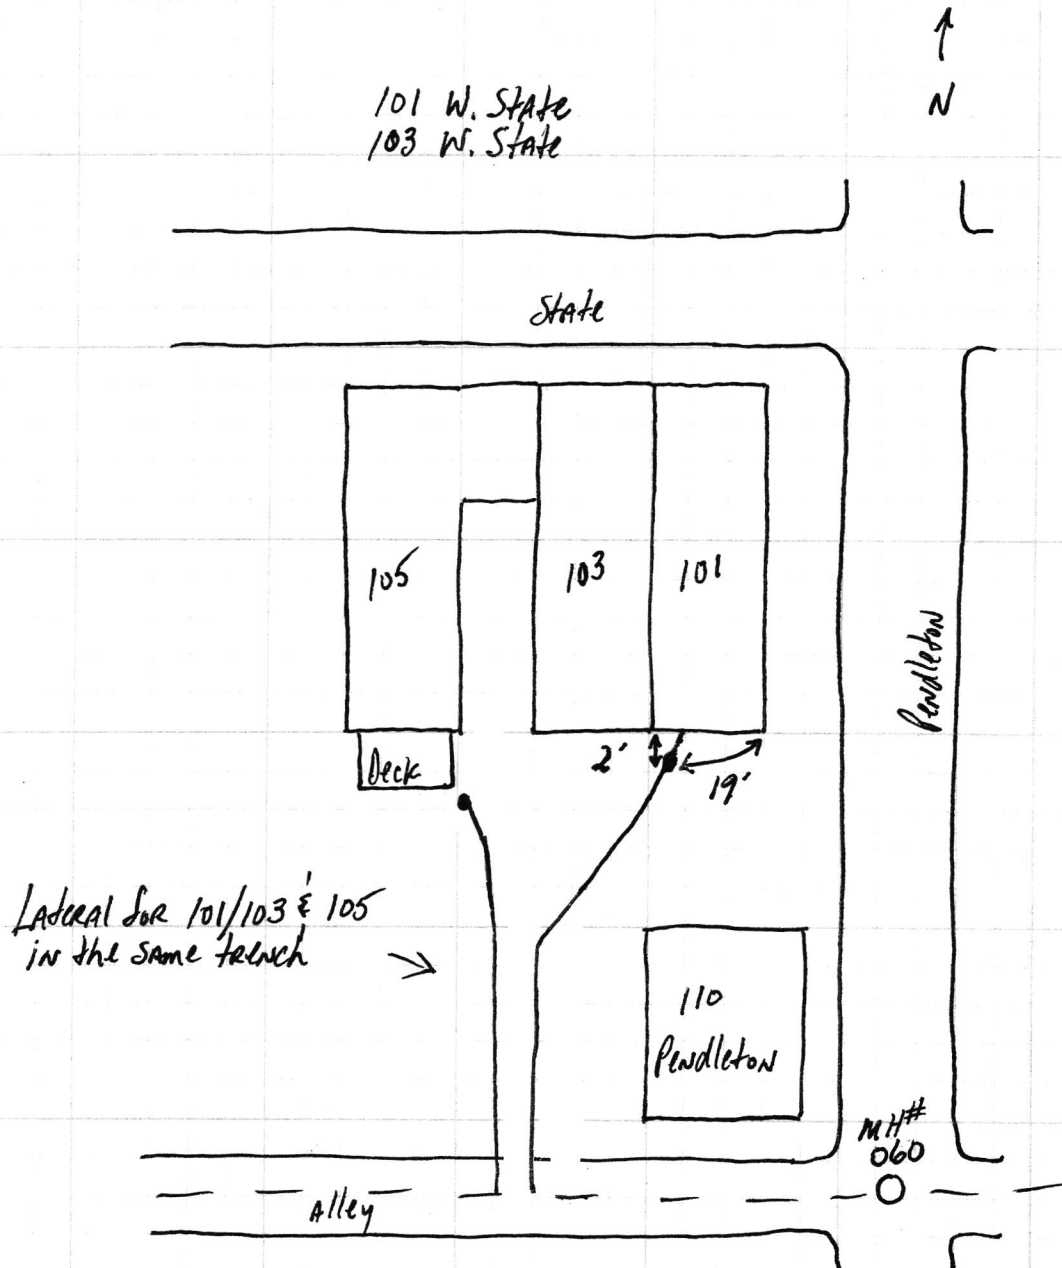



ON 11/18/18

8.15.18