



FALL CREEK REGIONAL WASTE DISTRICT

Box 44, Pendleton, Indiana 46064

2.000 4360.00

Nº 001404

APPLICATION FOR SEWER PERMIT

Permit No. \_\_\_\_\_ Date March 12, 1986

Permit Void 90 days from Date of Issuance

Owner Name David A. Cress Surge, 12 60031

Property Address 1011 Lancashire Lane

Lot # \_\_\_\_\_ P.O. Box \_\_\_\_\_

Town Pendleton, IN Zip Code 46064

Phone (312) 356-2097 Home Water Meter \_\_\_\_\_

(312) 662-4850 Work

\$ 1.50.00 Tap on Fee Paid

\$ 25.00 Inspection fee paid

Application is hereby made for connection to the Fall Creek Regional Waste District Sewer System for the above listed property - Permit Type: Residential ☒, Commercial \_\_\_\_\_, Industrial \_\_\_\_\_, or Governmental/Institutional \_\_\_\_\_. User Information \_\_\_\_\_.

All workmanship and materials shall conform to the standards of the District Ordinance as described in Ordinance 84-2 and 84-3 as amended. Acceptance and approval must be made by the District inspector or his duly authorized representative before backfilling and final connection is made to the main sewer lines. Any violation of applicable regulations will cause all lines and appurtenances in violation to be removed and replaced at the owners expense.

The Fall Creek Regional Waste District is responsible for the inspection, approval of materials, and installation techniques only. All costs for materials and installation and any liabilities resulting from same is the sole responsibility of the property owner.

I have read and fully understand the above provisions and agree to comply by said provisions.

APPLICANT(S) SIGNATURE

\*\*\*\*\*

INSPECTOR Tim

Date inspected 5-1-86 Approved ☒ Rejected \_\_\_\_\_

Reason for rejection \_\_\_\_\_

Date reinspected \_\_\_\_\_ Approved \_\_\_\_\_ Rejected \_\_\_\_\_

Notes: 4"

Size Pipe \_\_\_\_\_

Type Pipe PVC

Basement Yes ☒ No ☒


Sump Pump Yes ☒ No ☒

Downspout to Ground Yes ☒ No \_\_\_\_\_

Septic Tank Pumped & filled Yes ☒ No ☒

Contractor Regan

Special Conditions \_\_\_\_\_

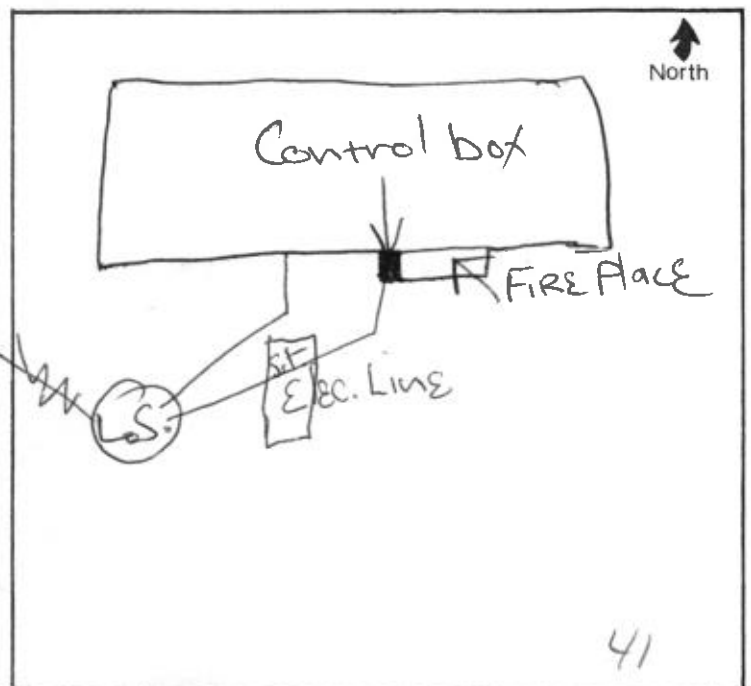

# FALL GREEN REGIONAL WASTE DISTRICT

800 22 4444 (toll-free)



NO. 001401

Handwritten notes and signatures at the top of the page, including a signature that appears to be "John Smith" and some illegible text.

Handwritten notes and signatures in the middle section of the page, including a signature that appears to be "John Smith" and some illegible text.

Handwritten notes and signatures in the lower middle section of the page, including a signature that appears to be "John Smith" and some illegible text.

Handwritten notes and signatures in the lower section of the page, including a signature that appears to be "John Smith" and some illegible text.



Handwritten notes and signatures on the right side of the page, including a signature that appears to be "John Smith" and some illegible text.