

add order on file

26-01986.00



FALL CREEK REGIONAL WASTE DISTRICT

9378 S. 650 West PO Box 59
Pendleton, IN 46064-0059 778-7544

Drawings for

1012 York Dr.

Nº 2857

APPLICATION FOR SEWER PERMIT

Date 8-3-00

Permit Void 90 days from Date of Issuance

Owner Name STEPHEN W. & NANCY J. LAY

Property Address 1012 YORK DR

Lot # P.O. Box

Town PENDLETON, IN Zip Code 46064

Phone (765) 778-2964 City Water Well ☒

\$ 2556.00 Tap on Fee Paid grinder unit paid for

\$ Inspection fee paid contractor - Mahuran

Application is hereby made for connection to the Fall Creek Regional Waste District Sewer System for the above listed property - Permit Type: Residential ☒, Commercial, Industrial, or Governmental/Institutional. User Information

All workmanship and District Ordinance as described. Acceptance and approval by authorized representative to the main sewer lines. cause all lines and appurtenances at the owners expense. Septic Tank NOT Pumped to the standards of the and 84-3 as amended. Inspector or his duly authorized representative final connection is made in accordance with applicable regulations will be removed and replaced

The Fall Creek Regional Waste District is responsible for the inspection, approval of materials, and installation techniques only. All costs for materials and installation and any liabilities resulting from same is the sole responsibility of the property owner.

I have read and fully understand the above provisions and agree to comply by said provisions.

Nancy J. Lay

APPLICANT(S) SIGNATURE


INSPECTOR [Signature]

Date inspected 8-22-00 Approved Rejected

Reason for rejection

Date reinspected Approved Rejected

Notes:
Size Pipe 1 1/2" PM / 4" CAT
Type Pipe 160 / 36
Basement Yes No
Sump Pump Yes No
Downspout to Ground Yes No
Septic Tank Pumped & filled Yes No
Contractor ONE SOURCE
Special Conditions Bore 1 1/2 PM
Existing Home
New Construction

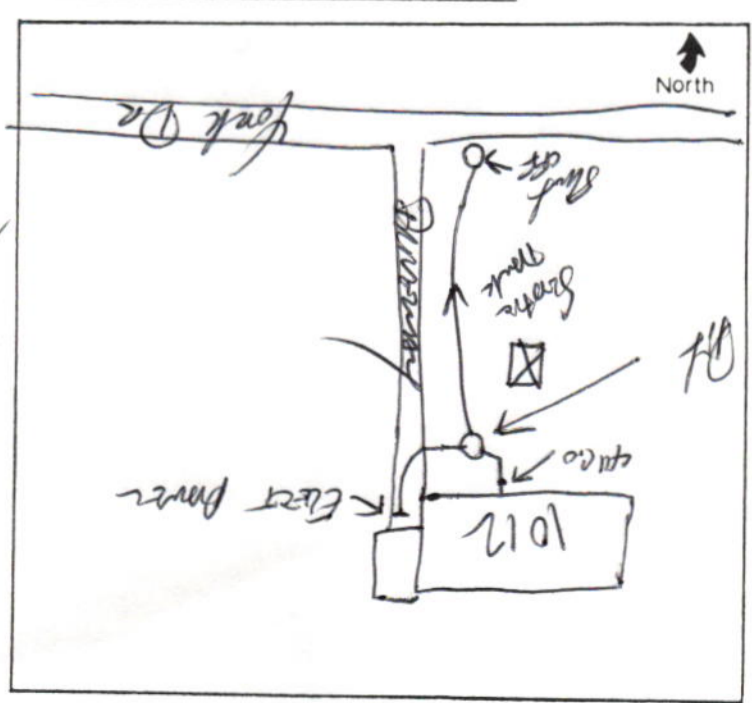

Fax: 765-778-7545

Amount Due	\$2,200.45
------------	------------