

add order on file

24-01988.00



FALL CREEK REGIONAL WASTE DISTRICT

9378 S. 650 West PO Box 59
Pendleton, IN 46064-0059 778-7544

Drawings for

1013 York Dr

No 2856

APPLICATION FOR SEWER PERMIT

Date 8-3-00

Permit Void 90 days from Date of Issuance

Owner Name STEPHEN M. LAY

Property Address 1013 YORK DR. PENDLETON, IN 46064

Lot # P.O. Box

Town PENDLETON, IN Zip Code 46064

Phone (765) 778-7820 City Water Well ☒

\$ 2556.00 Tap on Fee Paid grinder unit paid for
\$ Inspection fee paid Contractor - Mahurin

Application is hereby made for connection to the Fall Creek Regional Waste District Sewer System at the above listed property - Permit Type: Residential ☒, Commercial ☐, or Governmental/Institutional ☐. Use ☐

Septic Tank
NOT Pumped

All workmanship and materials shall conform to the standards of the District Ordinance as described in the District Ordinance and 84-3 as amended. Acceptance and approval of the installation shall be made by the District Inspector or his duly authorized representative. Final connection is made to the main sewer lines. All regulations will be removed and replaced at the owners expense.

The Fall Creek Regional Waste District is responsible for the inspection, approval of materials, and installation techniques only. All costs for materials and installation and any liabilities resulting from same is the sole responsibility of the property owner.

I have read and fully understand the above provisions and agree to comply by said provisions.


Stephen M. Lay by Nancy Lay
APPLICANT(S) SIGNATURE

Date inspected 8-22-00 INSPECTOR [Signature] Approved ☒ Rejected ☐

Reason for rejection

Date reinspected Approved Rejected

Notes:
Size Pipe 1 1/2 in / 4" Lat
Type Pipe 160 / 35
Basement Yes ☐ No ☒
Sump Pump Yes ☐ No ☒
Downspout to Ground Yes ☒ No ☐
Septic Tank Pumped & filled Yes ☒ No ☐
Contractor One Source
Special Conditions One 1 1/2 in
Existing Home ☒
New Construction ☐

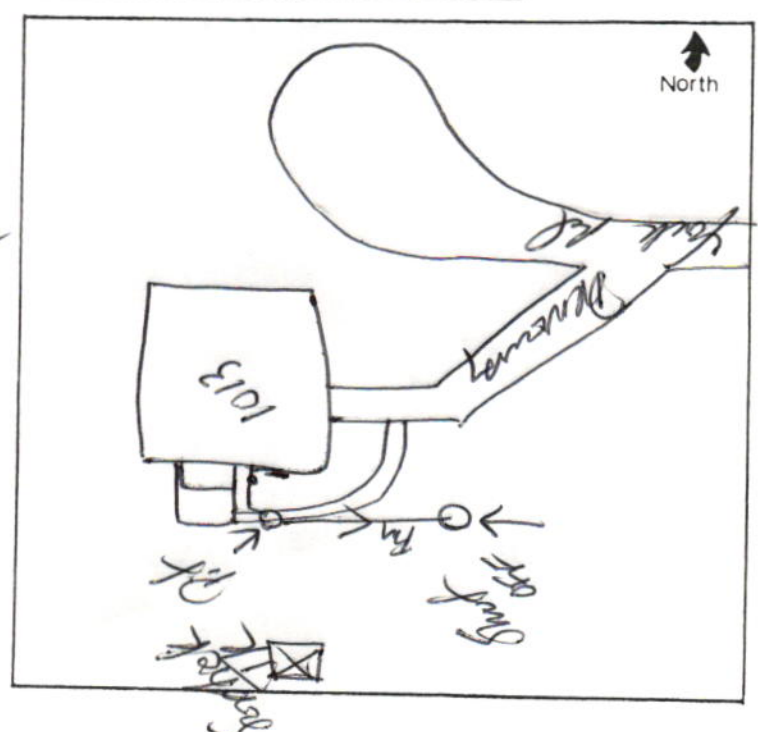

9378 S. CR 650 W.
P.O. Box 59
Pendleton, IN 46064
Phone: 765-778-7544

INVOICE

Name	Stephen M. Lay		Acct #	26-01986.00	
Address	1012 York Drive				
City	Pendleton	State	IN	Zip	46064
Phone					

Cut here

Name	Stephen M. Lay		Acct #	26-01986.00	
Address	1012 York Drive				
City	Pendleton	State	IN	Zip	46064
Phone	0				

Project Area # E
W.O. #
Due Date 90 days

Amount Due	\$2,255.15
------------	------------