



FALL CREEK REGIONAL WASTE DISTRICT

Box 44, Pendleton, Indiana 46064

220427500

Mustin Builders

APPLICATION FOR SEWER PERMIT

Nº 001799

Permit No. _____ Date Sept 19, 1991
Permit Void 90 days from Date of Issuance
Owner Name Bauer, Bart
Property Address 1018 Lancashire Ln
Lot # _____ P.O. Box _____
Town Pendleton, IN Zip Code 46064
Phone _____ Water Meter _____
\$ 2,880.00 Tap on Fee Paid
\$ 25.00 Inspection fee paid

Application is hereby made for connection to the Fall Creek Regional Waste District Sewer System for the above listed property - Permit Type: Residential X, Commercial _____, Industrial _____, or Governmental/Institutional _____. User Information _____

All workmanship and materials shall conform to the standards of the District Ordinance as described in Ordinance 84-2 and 84-3 as amended. Acceptance and approval must be made by the District inspector or his duly authorized representative before backfilling and final connection is made to the main sewer lines. Any violation of applicable regulations will cause all lines and appurtenances in violation to be removed and replaced at the owners expense.

The Fall Creek Regional Waste District is responsible for the inspection, approval of materials, and installation techniques only. All costs for materials and installation and any liabilities resulting from same is the sole responsibility of the property owner.

I have read and fully understand the above provisions and agree to comply by said provisions.

APPLICANT(S) SIGNATURE

INSPECTOR Tim

Date inspected 10-11-91 Approved / Rejected _____

Reason for rejection _____

Date reinspected _____ Approved _____ Rejected _____

Notes:

Size Pipe 4"

Type Pipe Sch 40

Basement Yes ☒ No ☐


Sump Pump Yes ☐ No ☒

Downspout to Ground Yes ☒ No ☐

Septic Tank Pumped & filled Yes ☒ No ☐

Contractor Mustin Builders

Special Conditions _____

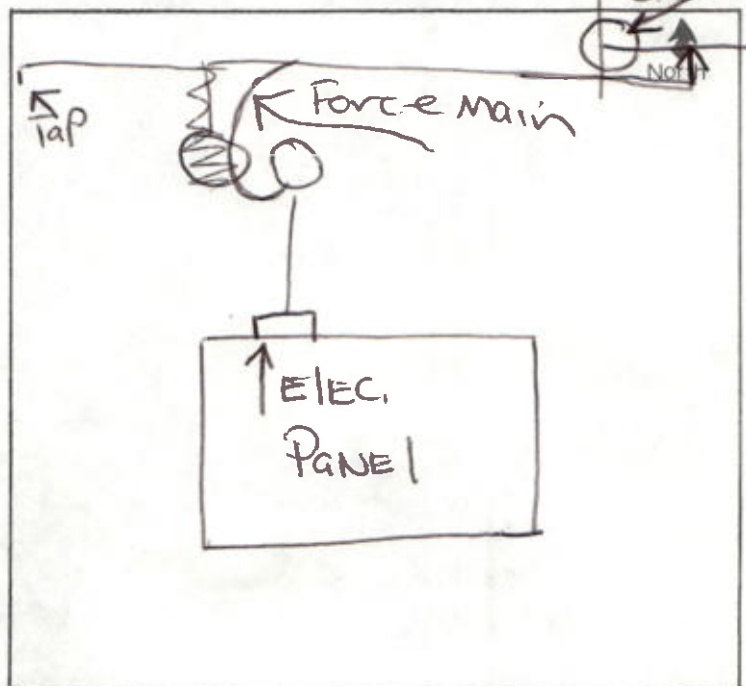



FALL CREEK REGIONAL WASTE DISTRICT

Business Administration Institute 1984

1984-1985

Administrative Building

NO 001789

Sept 19, 1991


Barney, Lane
1018 Commercial Dr

1018

Penetration

2,880.00

32.00

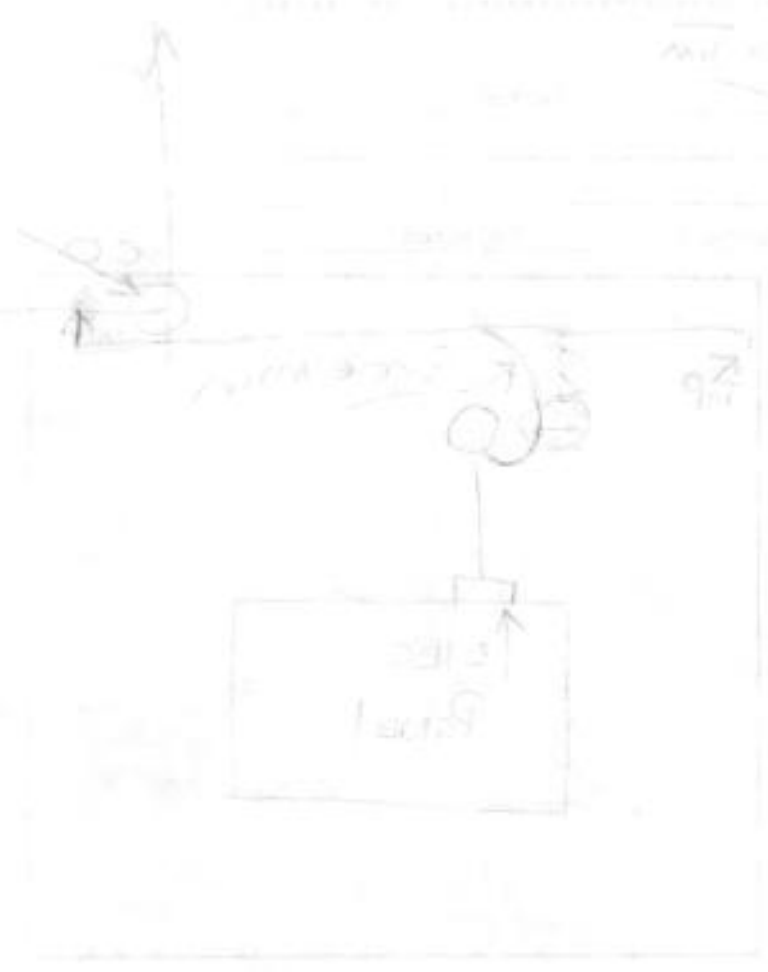

Handwritten notes and signatures in the bottom right section of the document, including a signature that appears to read 'Barney, Lane'.