

add orders  
on file



# FALL CREEK REGIONAL WASTE DISTRICT

9378 S. 650 West PO Box 59  
Pendleton, IN 46064-0059 778-7544

101 W Madison # 3-05763.99  
504 S Pendleton 3-05765.99

## APPLICATION FOR SEWER PERMIT

No 2193

Date 5/2/95

Permit Void 90 days from Date of Issuance

Owner Name Bryce Lewis

Property Address 101 W Madison & 504 S Pendleton Ave

Lot # \_\_\_\_\_ P.O. Box \_\_\_\_\_

Town Pendleton, IN Zip Code 46064

Phone \_\_\_\_\_ City Water ☒ Well \_\_\_\_\_

\$ 700.00 Tap on Fee Paid \$ 725 credit from

\$ 25.00 Inspection fee paid existing house

Application is hereby made for connection to the Fall Creek Regional Waste District Sewer System for the above listed property - Permit Type: Residential ☒, Commercial \_\_\_\_\_, Industrial \_\_\_\_\_, or Governmental/Institutional \_\_\_\_\_. User Information \_\_\_\_\_.

All workmanship and materials shall conform to the standards of the District Ordinance as described in Ordinance 84-2 and 84-3 as amended. Acceptance and approval must be made by the District inspector or his duly authorized representative before backfilling and final connection is made to the main sewer lines. Any violation of applicable regulations will cause all lines and appurtenances in violation to be removed and replaced at the owners expense.

The Fall Creek Regional Waste District is responsible for the inspection, approval of materials, and installation techniques only. All costs for materials and installation and any liabilities resulting from same is the sole responsibility of the property owner.

I have read and fully understand the above provisions and agree to comply by said provisions.

Bryce Lewis

APPLICANT(S) SIGNATURE

\*\*\*\*\*

INSPECTOR Tim

Date inspected 8/95 Approved ☒ Rejected ☒

Reason for rejection \_\_\_\_\_

Date reinspected \_\_\_\_\_ Approved \_\_\_\_\_ Rejected \_\_\_\_\_

### Notes:

Size Pipe 6"

Type Pipe SDR 35

Basement Yes \_\_\_\_\_ No ☒

Sump Pump Yes \_\_\_\_\_ No ☒

Downspout to Ground Yes ☒ No \_\_\_\_\_

Septic Tank Pumped & filled Yes \_\_\_\_\_ No \_\_\_\_\_


Contractor Dick Goodber

Special Conditions (Did not BCO

PIPE)

Existing Home \_\_\_\_\_

New Construction ☒

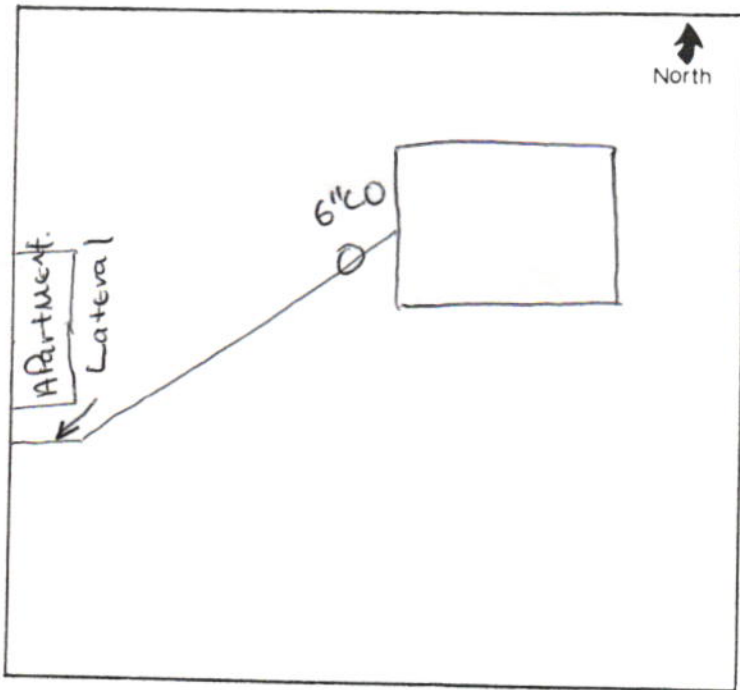

BRYCE L OR MARLA A LEWIS 12/83  
311-52-1273 306-50-9402  
3892 ARROWHEAD CT PH 326-4175  
GREENFIELD IN 46140

2902

71-7257/2749

May 2 19 95

PAY TO THE  
ORDER OF

FALL CREEK REGIONAL WASTE DISTRICT \$ 725<sup>00</sup>/<sub>100</sub>

SEVEN HUNDRED TWENTY FIVE <sup>00</sup>/<sub>100</sub> DOLLARS

**INDEPENDENT FEDERAL**

ANDERSON, INDIANA 46016

CREDIT UNION

FOR

SEWER TAP

⑆274972579⑆

2902