



FALL CREEK REGIONAL WASTE DISTRICT

9378 S. 650 West PO Box 59  
Pendleton, IN 46064-0059 778-7544

add order  
on file

22-04265.00

APPLICATION FOR SEWER PERMIT

Nº 2066

Date

4/20/94

Permit Void 90 days from Date of Issuance

Owner Name

Terry Richwine Jeff Jamerson

Property Address

1022

Lancashire Lane

Lot #

17- Pendle Hill

P.O. Box

Town

Pendleton

, IN

Zip Code

46064

Phone

City Water

Well

✓

\$ 100.00

Tap on Fee Paid

\$ 25.00

Inspection fee paid

Application is hereby made for connection to the Fall Creek Regional Waste District Sewer System for the above listed property - Permit Type: Residential ☒, Commercial ☐, Industrial ☐, or Governmental/Institutional ☐. User Information

All workmanship and materials shall conform to the standards of the District Ordinance as described in Ordinance 84-2 and 84-3 as amended. Acceptance and approval must be made by the District inspector or his duly authorized representative before backfilling and final connection is made to the main sewer lines. Any violation of applicable regulations will cause all lines and appurtenances in violation to be removed and replaced at the owners expense.

The Fall Creek Regional Waste District is responsible for the inspection, approval of materials, and installation techniques only. All costs for materials and installation and any liabilities resulting from same is the sole responsibility of the property owner.

I have read and fully understand the above provisions and agree to comply by said provisions.

Terry Richwine

APPLICANT(S) SIGNATURE

INSPECTOR

TJR

Date inspected

4/5/95

Approved

Rejected

Reason for rejection

Date reinspected

Approved

Rejected

Notes:

Size Pipe

4"

Type Pipe

sch. 40

Basement Yes

No

SEPAuf.

Sump Pump Yes

No

Downspout to Ground Yes

No

Septic Tank Pumped & filled Yes

No

Contractor

Terry Schafer


Special Conditions

Existing Home

New Construction

✓

TAP From  
Lot 18

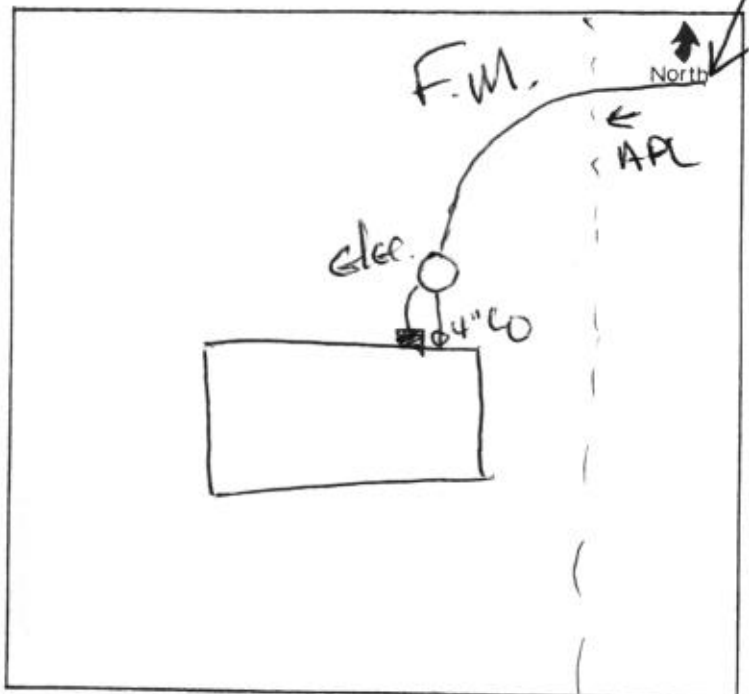

12/12/2012 10:00 AM



12/12/2012

12/12/2012

12/12/2012 10:00 AM


12/12/2012 10:00 AM

12/12/2012 10:00 AM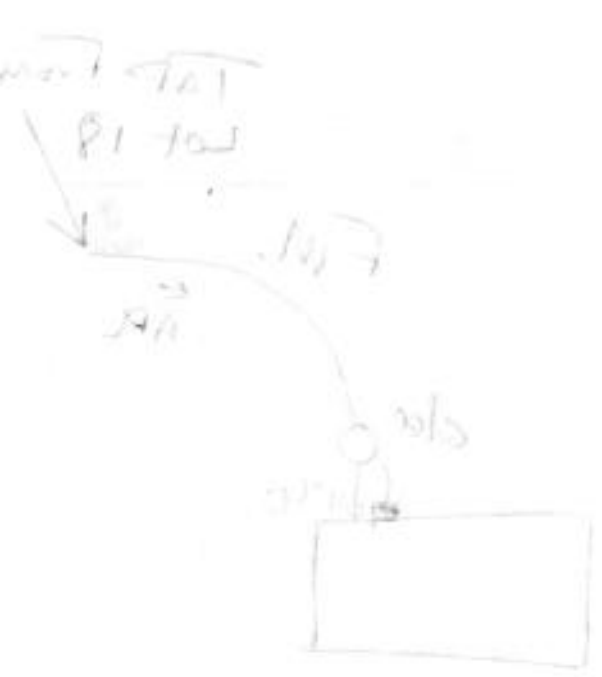

