


#6617

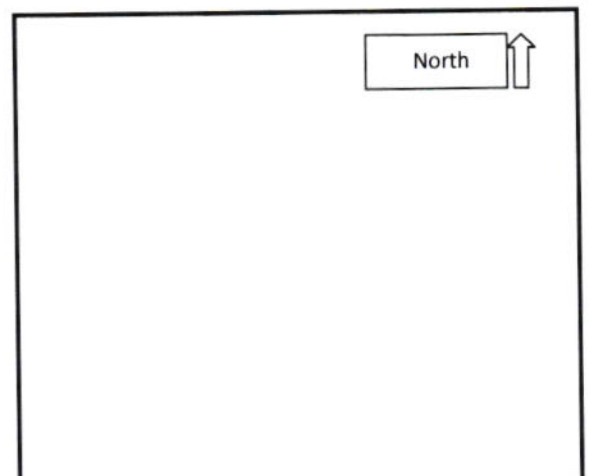

Gidw.

PROJECT _____ SHEET _____ OF _____

SUBJECT _____ DATE 12-15-16

JOB NO. SRF

BY Brackenfy

102 E. Central Way

