

FALL CREEK REGIONAL WASTE DISTRICT

9378 S 650 WEST, P.O. BOX 59, PENDLETON, IN 46064

765-778-7544

AGREEMENT FOR SANITARY SEWER SERVICE

add order
on file
4478
21-01845.00

This Agreement made and entered into this 18th day of July, 2001, between FALL CREEK REGIONAL WASTE DISTRICT ("District") and Jim McCoy ("Applicant") regarding the provision of sanitary sewer service, and the assignment of capacity in, and connection to, the District's facilities for the premises located at 102 S. Meridian.

NOW THEREFORE, the parties, in consideration of the mutual promises set out in this Agreement, the receipt and sufficiency of which is hereby acknowledged, agree as follows:

1. The District's workmanship and materials shall conform to all District ordinances and the District must accept and approve all work and materials before backfilling and final connection to be removed. Violation of this provision will cause all lines and appurtenances in violation to be removed at Applicant's expense.

2. The District may enter upon the Applicant's premises at all reasonable times to inspect, repair, or replace any connection with the District's service or which has an impact on said service.

3. The Applicant shall be responsible for all monthly user rates, capacity charges, and tap fees. The failure to pay any rate charge or fee may result in a lien against the property and/or the termination of service to the property, the cost of which will be borne by Applicant, including, but not limited to, all attorney's fees and collection costs.

4. The District shall not be responsible for any damages as a result of any failure to supply service unless said damages are due to default, neglect or culpability on the part of the District.

5. If there is an available sanitary sewer within three hundred (300) feet of the property line, the property owner shall be required to connect to the District's sanitary sewer system.

6. The Applicant and District agree that the provision of sanitary sewer service touches and concerns the property and the terms of this Agreement bind the District and Applicant and their heirs, executors, administrators, personal representatives, successors, agents, attorneys, assigns, designees, and transferees.

The parties hereto have read and fully understand the above provisions and agree to comply with said provisions.

FALL CREEK REGIONAL WASTE DISTRICT
Jan E. Carey
Signature

APPLICANT
Jim McCoy
Signature

STATE OF INDIANA)
) SS:
COUNTY OF MADISON)

SUBSCRIBED and sworn to before me this 18th day of July, 2001.

My Commission Expires:
4-29-2009

Signature Jan E. Carey
Printed Jan E. Carey
Notary Public
Resident of Madison County

INSPECTOR Tim DATE INSPECTED 7-18-01 APPROVED ✓ REJECTED _____

REASON FOR REJECTION _____

DATE REINSPECTED _____ APPROVED _____ REJECTED _____

NOTES:
SIZE PIPE 6" TYPE PIPE SDR 35

BASEMENT YES _____ NO ✓

SUMP PUMP YES _____ NO ✓

DOWNSPOUT TO GROUND YES ✓ NO _____


SEPTIC TANK PUMPED & FILLED YES _____ NO _____

CONTRACTOR BL Brown

SPECIAL CONDITIONS cut in a new Tee

EXISTING HOME _____

NEW CONSTRUCTION ✓

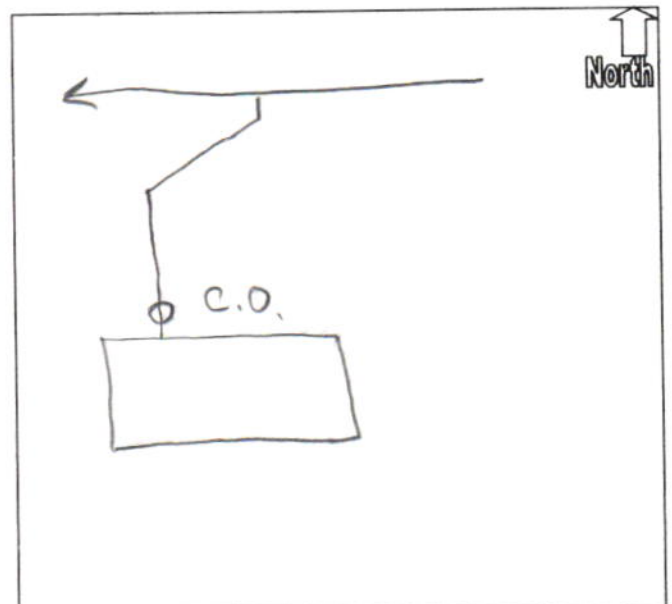

VENDEL-WILSON VENTURES

600 E. BROADWAY
FORTVILLE, IN 46040-1546

3388

Date 7-18-01

71-367/749
D6

Pay to the
Order of F.C.R.W.V.

\$ 2885⁰⁰/₁₀₀

TWO THOUSAND EIGHT HUNDRED EIGHTY FIVE⁰⁰/₁₀₀ - Dollars

Security features
are included.
Details on the
back.


GREENFIELD BANKING COMPANY
FORTVILLE, IN 46040

For _____

Sto Vendell

MP

⑆074903670⑆

03388

MAROON SHEFFIELD V