



FALL CREEK REGIONAL WASTE DISTRICT

9378 S. 650 West PO Box 59
Pendleton, IN 46064-0059 778-7544

Original sent
to owner
11/30/95

APPLICATION FOR SEWER PERMIT

Nº 2328

Date _____

Permit Void 90 days from Date of Issuance

Owner Name Dennis McCammon

Property Address 1032 Chipmunk Lane

Lot # _____ P.O. Box _____

Town Pendleton, IN Zip Code 46064

Phone _____ City Water _____ Well ☒

\$ _____ Tap on Fee Paid

\$ _____ Inspection fee paid

Application is hereby made for connection to the Fall Creek Regional Waste District Sewer System for the above listed property - Permit Type: Residential ☒, Commercial _____, Industrial _____, or Governmental/Institutional _____. User Information _____.

All workmanship and materials shall conform to the standards of the District Ordinance as described in Ordinance 84-2 and 84-3 as amended. Acceptance and approval must be made by the District inspector or his duly authorized representative before backfilling and final connection is made to the main sewer lines. Any violation of applicable regulations will cause all lines and appurtenances in violation to be removed and replaced at the owners expense.

The Fall Creek Regional Waste District is responsible for the inspection, approval of materials, and installation techniques only. All costs for materials and installation and any liabilities resulting from same is the sole responsibility of the property owner.

I have read and fully understand the above provisions and agree to comply by said provisions.

APPLICANT(S) SIGNATURE

INSPECTOR B

Date inspected 12-1-95 Approved ☒ Rejected _____

Reason for rejection _____

Date reinspected _____ Approved _____ Rejected _____

Notes:

Size Pipe 6 "

Type Pipe PVC

Basement Yes ☒ No ☒

Sump Pump Yes _____ No ☒

Downspout to Ground Yes ☒ No _____


Septic Tank Pumped & filled Yes _____ No ☒

Contractor FARMER

Special Conditions _____

Existing Home ☒

New Construction _____

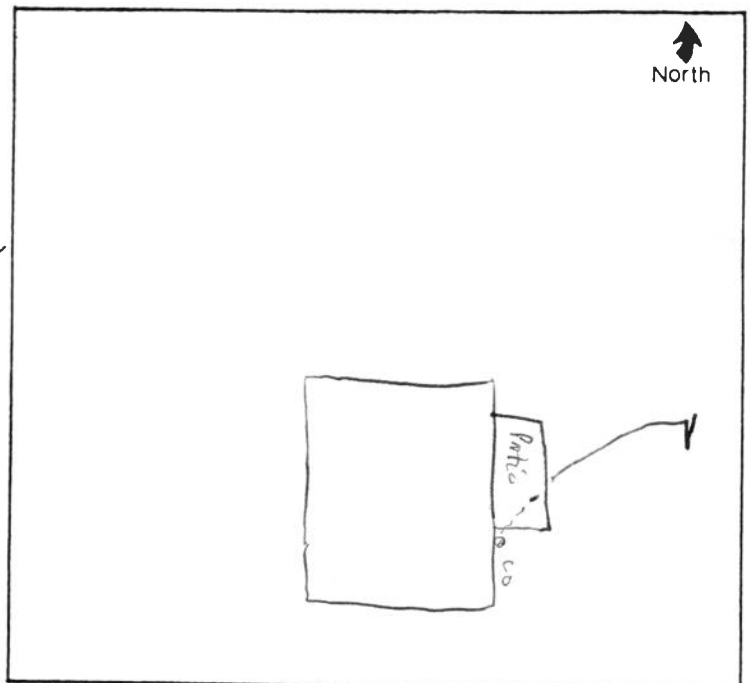





FALL CREEK REGIONAL WASTE DISTRICT

9378 S. 650 West PO Box 59
Pendleton, IN 46064-0059 778-7544original sent
to owner
11/30/95

APPLICATION FOR SEWER PERMIT

Nº 2328

Date _____

Permit Void 90 days from Date of Issuance

Owner Name Dennis McCammonProperty Address 1032 Chipmunk Lane

Lot # _____ P.O. Box _____

Town Pendleton, IN Zip Code 46064Phone _____ City Water _____ Well ☒

\$ _____ Tap on Fee Paid

\$ _____ Inspection fee paid

Application is hereby made for connection to the Fall Creek Regional Waste District Sewer System for the above listed property - Permit Type: Residential ☒, Commercial _____, Industrial _____, or Governmental/Institutional _____. User Information _____.

All workmanship and materials shall conform to the standards of the District Ordinance as described in Ordinance 84-2 and 84-3 as amended. Acceptance and approval must be made by the District inspector or his duly authorized representative before backfilling and final connection is made to the main sewer lines. Any violation of applicable regulations will cause all lines and appurtenances in violation to be removed and replaced at the owners expense.

The Fall Creek Regional Waste District is responsible for the inspection, approval of materials, and installation techniques only. All costs for materials and installation and any liabilities resulting from same is the sole responsibility of the property owner.

I have read and fully understand the above provisions and agree to comply by said provisions.

APPLICANT(S) SIGNATURE _____

INSPECTOR BDate inspected 12-1-95 Approved ☒ Rejected _____

Reason for rejection _____

Date reinspected _____ Approved _____ Rejected _____

Notes:


Size Pipe 6 "Type Pipe PVCBasement Yes ☒ No ☒Sump Pump Yes _____ No ☒Downspout to Ground Yes ☒ No _____Septic Tank Pumped & filled Yes _____ No ☒Contractor Farmer

Special Conditions _____

Existing Home ☒

New Construction _____

North

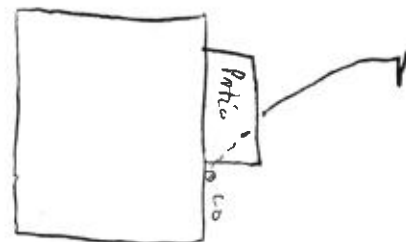

*Dennis & Reva Mc Cammon
1032 Chipmunk Lane
Pendleton, Indiana 46064*


*Monday, July 06, 1998
2:25:13 PM*

Enclosed is check # 4357 for tap in fee at 1032 Chipmunk Lane, Pendleton, Indiana. The amount is \$ 2700.00. This is now paid in full.

Thank-you

Reva Mc Cammon
Reva McCammon

Dennis & Reva Mc Cammon
1032 Chipmunk Lane
Pendleton, Indiana 46064

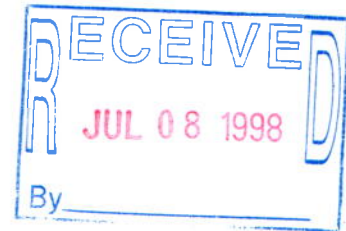

Monday, July 06, 1998
2:25:13 PM

Enclosed is check # 4357 for tap in fee at 1032 Chipmunk Lane, Pendleton, Indiana. The amount is \$ 2700.00. This is now paid in full.

Thank-you

Reva Mc Cammon
Reva McCammon

MADISON CO. GLASS & MIRROR REVA AND DENNIS Mc CAMMON 107 E. STATE ST. PH. 765-778-3555 PENDLETON, IN 46064		20-7043/2740 175009156	4357
DATE <u>7/6/98</u>			
PAY TO THE ORDER OF	<u>FALL CREEK REGIONAL WASTE</u>	\$ <u>2700.00</u>	
<u>Two thousand-seven hundred No</u>		DOLLARS	
FIRST INDIANA BANK INDIANAPOLIS, INDIANA 46204		8-91	
MEMO <u>FOR 1032 CHIPMUNK LN</u> <u>TAP FEE</u>		<i>Reva Mc Cammon</i> MP	
⑆274070439⑆ 175009156⑆ 4357			

SAFETY PAPER

Dennis & Reva Mc Cammon
1032 Chipmunk Lane
Pendleton, Indiana 46064

Monday, July 06, 1998
2:25:13 PM

Enclosed is check # 4357 for tap in fee at 1032 Chipmunk Lane, Pendleton, Indiana. The amount is \$ 2700.00. This is now paid in full.

Thank-you

Reva Mc Cammon
Reva McCammon

MADISON CO. GLASS & MIRROR REVA AND DENNIS Mc CAMMON 107 E. STATE ST. PH. 765-778-3555 PENDLETON, IN 46064		20-7043/2740 175009156	4357
DATE <u>7/6/98</u>			
PAY TO THE ORDER OF	<u>FALL CREEK REGIONAL WASTE</u>	\$ <u>2700.00</u>	
<u>Two thousand-seven hundred No</u>		DOLLARS	
FIRST INDIANA® BANK INDIANAPOLIS, INDIANA 46204		8-91	
MEMO <u>FOR 1032 CHIPMUNK LN</u>		<i>Reva McCammon</i> MP	
<u>TAP FEE</u>			
⑆ 274070439⑆ 175009156⑆ 4357			

DELIVER WALLET OR DUPLICATE © SAFETY PAPER

100

100

100