



FALL CREEK REGIONAL WASTE DISTRICT

9378 S. 650 West PO Box 59
Pendleton, IN 46064-0059 778-7544

APPLICATION FOR SEWER PERMIT

Nº 2840

Date 12 July 2000

Permit Void 90 days from Date of Issuance

Owner Name Richard & Wanda HarveyProperty Address 103 Louise Street

Lot # _____ P.O. Box _____

Town Pendleton, IN Zip Code 46064-9113Phone 745-778-3776 City Water _____ Well ☒

\$ 2556.00 Tap on Fee Paid pd. 500.00 balance due 1700.45
\$ _____ Inspection fee paid pd. 1700.45 on 8-14-2000

Application is hereby made for connection to the Fall Creek Regional Waste District Sewer System for the above listed property - Permit Type: Residential ☒, Commercial _____, Industrial _____, or Governmental/Institutional _____. User Information _____.

All workmanship and materials shall conform to the standards of the District Ordinance as described in Ordinance 84-2 and 84-3 as amended. Acceptance and approval must be made by the District inspector or his duly authorized representative before backfilling and final connection is made to the main sewer lines. Any violation of applicable regulations will cause all lines and appurtenances in violation to be removed and replaced at the owners expense.

The Fall Creek Regional Waste District is responsible for the inspection, approval of materials, and installation techniques only. All costs for materials and installation and any liabilities resulting from same is the sole responsibility of the property owner.

I have read and fully understand the above provisions and agree to comply by said provisions.

Wanda J. Harvey
APPLICANT(S) SIGNATURE

INSPECTOR DonDate inspected 10/27/00 Approved _____ Rejected _____

Reason for rejection _____

Date reinspected _____ Approved _____ Rejected _____

Notes:

Size Pipe 6 "Type Pipe 160/26Basement Yes _____ No ☒Sump Pump Yes _____ No ☒Downspout to Ground Yes ☒ No _____


Septic Tank Pumped & filled Yes _____ No _____

Contractor Gerry Hancock

Special Conditions _____

Existing Home ☒

New Construction _____

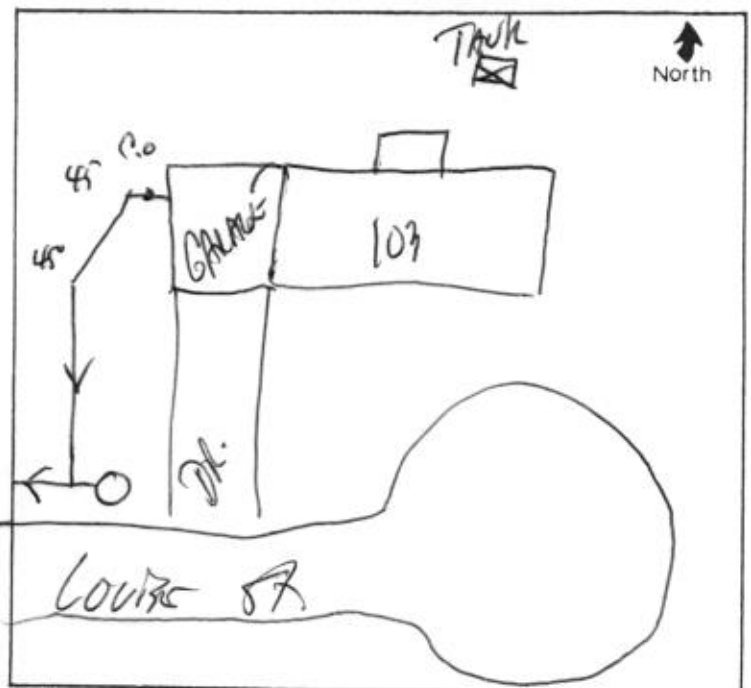

24-0156-00

WEST CREEK REGIONAL WASTE DISTRICT
1400 W. 10th Ave. Suite 100
Denver, CO 80202
Tel: 303.733.1100



0185

10/21/00

10/21/00


10/21/00

10/21/00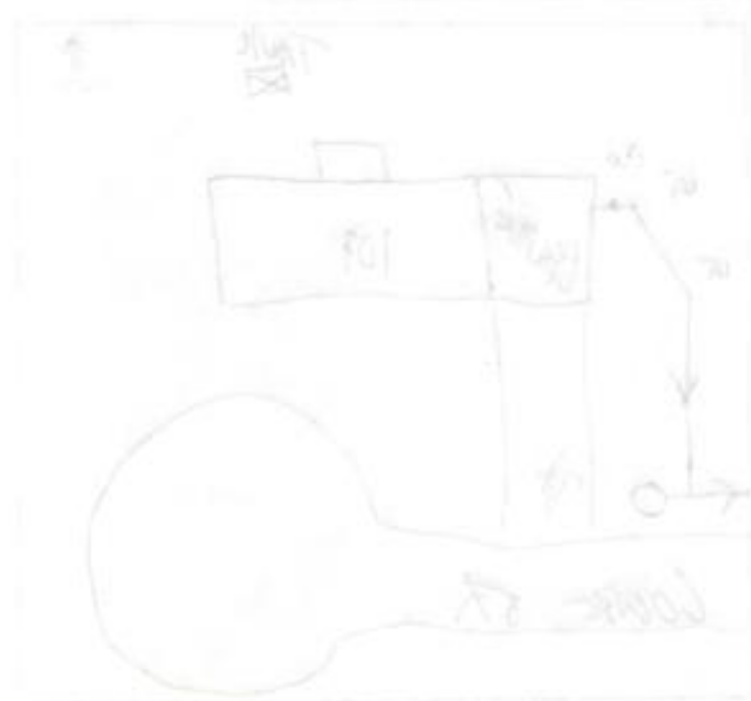

9378 S. CR 650 W.
P.O. Box 59
Pendleton, IN 46064
Phone: 765-778-7544

INVOICE

Name	Richard Harvey	Acct #	26-01560.00
Address	103 Louise St		
City	Pendleton	State	IN Zip 46064
Phone			

QTY	DESCRIPTION	UNIT PRICE	TOTAL
1	lap fee	\$400.00	\$400.00
1	capacity fee	\$2,156.00	\$2,156.00
		Sub-Total	\$2,556.00

DATE	PAYMENT	CHECK NUMBER	AMOUNT
	less payment of interim bill		\$355.55
	as of 4/19/00		
		Sub-Total	\$355.55

Detach bottom portion and return with payment

paid	-	500.00
		<u>700 45</u>

Cut here

Name	Richard Harvey	Acct #	26-01560.00
Address	103 Louise St		
City	Pendleton	State	IN Zip 46064
Phone	0		

Project Area # E
W.O. #
Due Date 90 days

Amount Due	\$2,200.45
------------	------------

1700.45

DAILY SUMMARY

CMD7-END

Account No 260156000 HARVEY, RICHARD

103 LOUISE STREET

Sel	Date	Tran Type	Total	Waste Wtr	Penalty
-----	------	-----------	-------	-----------	---------

	3/25/99	BILLING	27.35	27.35	
	4/26/99	BILLING	54.70	54.70	
	5/19/99	BILL ADJ	.41	.41	
	5/26/99	BILLING	82.05	82.05	
	6/25/99	BILLING	109.40	109.40	
	7/01/99	PAYMENT	109.40	109.40	
	7/26/99	BILLING	27.35	27.35	
	8/27/99	BILLING	54.70	54.70	
	9/22/99	PAYMENT	82.05	82.05	
	9/24/99	BILLING	82.05	82.05	
	10/25/99	BILLING	27.35	27.35	
	11/24/99	BILLING	54.70	54.70	
	12/07/99	PAYMENT	82.05	82.05	
	12/23/99	BILLING			
	1/24/00	BILLING	27.35	27.35	

total paid 355.55
last pymt. 4-19-00

DAILY SUMMARY

CMD7-END

Account No 260156000 HARVEY, RICHARD

103 LOUISE STREET

Sel	Date	Tran Type	Total	Waste Wtr	Penalty
-----	------	-----------	-------	-----------	---------

	2/25/00	BILLING	54.70	54.70	
	3/24/00	BILLING	82.05	82.05	
	4/19/00	PAYMENT	82.05	82.05	
	4/26/00	BILLING	27.35	27.35	

WANDA HARVEY 07-00
RICHARD HARVEY
765-778-3776
103 LOUISE ST.
PENDLETON, IN 46064

501

71-553/749
BRANCH 1

DATE 10 August 2000

PAY TO THE ORDER OF Fall Creek Regional Water District \$ 1700.45
One thousand seven hundred & 45/100 DOLLARS



Madison
Community Bank



FOR DEPOSIT # 26-01560.00

Wanda Harvey

⑆074905539⑆ 191 253 411 0501

© HARLAND 1995