

Gidw.


PROJECT Phase II SHEET \_\_\_\_\_ OF \_\_\_\_\_

SUBJECT \_\_\_\_\_ DATE 4-30-18

JOB NO. 4447

BY Atlas

W High  
103 S Pendleton

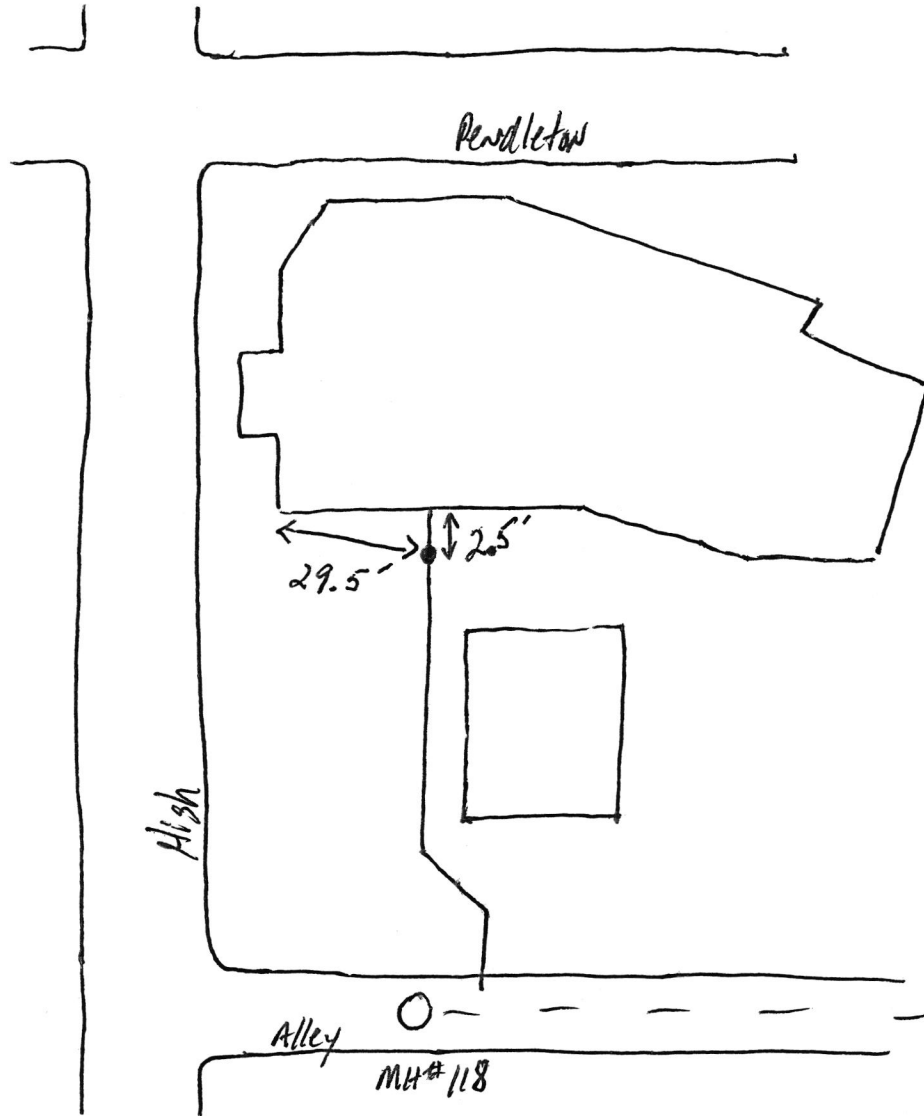

103 S Pendleton  
High

SRP  
Phase II

5.3.18

