



FALL CREEK REGIONAL WASTE DISTRICT

Box 44, Pendleton, Indiana 46064

1-0002977.00

Nº 000331

APPLICATION FOR SEWER PERMIT

Permit No. _____ Date 10/17/85

Permit Void 90 days from Date of Issuance

Owner Name Butch Ambrose

Property Address Wagon Estates 105 Inman Dr.

Lot # _____ P.O. Box 134

Town Lexells, IN Zip Code 46048

Phone 485-6043 Water Meter _____

\$ _____ Tap on Fee Paid

\$ 25.00 10/17/85 Inspection fee paid

Application is hereby made for connection to the Fall Creek Regional Waste District Sewer System for the above listed property - Permit Type: Residential x, Commercial _____, Industrial _____, or Governmental/Institutional _____. User Information _____.

All workmanship and materials shall conform to the standards of the District Ordinance as described in Ordinance 84-2 and 84-3 as amended. Acceptance and approval must be made by the District inspector or his duly authorized representative before backfilling and final connection is made to the main sewer lines. Any violation of applicable regulations will cause all lines and appurtenances in violation to be removed and replaced at the owners expense.

The Fall Creek Regional Waste District is responsible for the inspection, approval of materials, and installation techniques only. All costs for materials and installation and any liabilities resulting from same is the sole responsibility of the property owner.

I have read and fully understand the above provisions and agree to comply by said provisions.

Butch Ambrose (Margaret Ambrose)
APPLICANT(S) SIGNATURE

INSPECTOR [Signature]

Date inspected 10-23 Approved _____ Rejected _____

Reason for rejection _____

Date reinspected _____ Approved _____ Rejected _____

Notes:

Size Pipe 6" PVC

Type Pipe PVC

Basement Yes _____ No X

Sump Pump Yes _____ No X


Downspout to Ground Yes X No _____

? Septic Tank Pumped & filled Yes _____ No _____

Contractor PASSMORE

Special Conditions C.O. TO BE

FIXED WITH PARTS OBTAINED

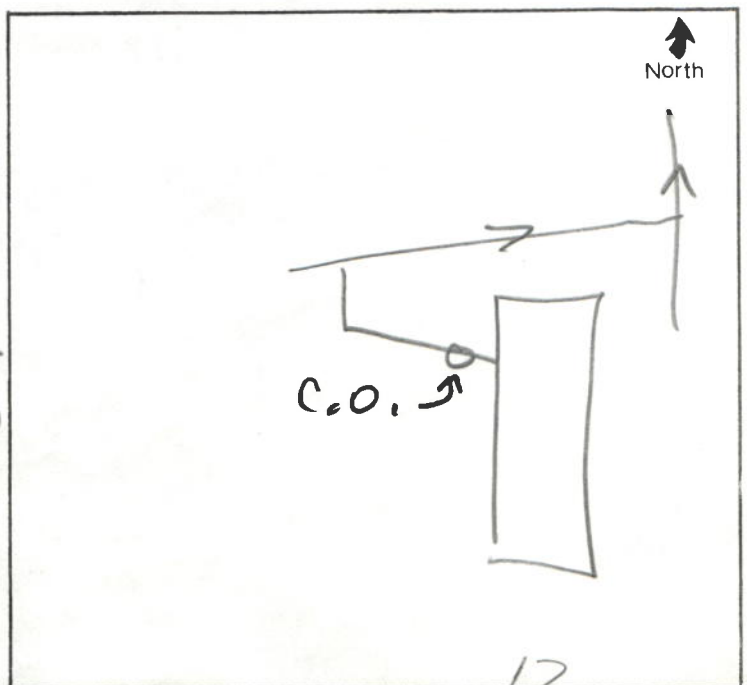



FALL CREEK REGIONAL WASTE DISTRICT

Box 44, Randolph, Indiana 46064

No 000381

APPLICATION FOR SEWER PERMIT

Permit No. _____ Date 10/17/82
Permit Valid 90 days from date of issuance
Owner Name Buck Ambrose
Property Address 125 Turner Dr
Lot # _____
Town _____ In Zip code 46048
Phone 468-6043 Water Meter _____
Tap on fee paid _____
Inspection fee paid 25.00 _____

Application is hereby made for connection to the Fall Creek Regional Waste District Sewer System for the above described property - Permit Type Residential ☒ Commercial ☐ Industrial ☐ or Governmental ☐ User Information _____

All workmanship and materials shall conform to the standards of the District Ordinance as described in Ordinances 84-1 and 84-2 as amended. Acceptance and approval must be made by the District and no work of its kind authorized unless previous notice is filed and final connection is made to the sewer lines. Any violation of applicable regulations will cause all fines and surcharges in violation to be imposed and collected at the owner's expense.


The Fall Creek Regional Waste District is responsible for the inspection, approval of materials, and installation requirements and all costs for materials and installation and any liabilities resulting therefrom is the sole responsibility of the property owner.

I have read and fully understand the above provisions and agree to comply with said provisions.

Buck Ambrose (Signature)
APPLICANT'S SIGNATURE

DATE INSPECTED 10-23 APPROVED [Signature] REJECTED _____
REASON FOR REJECTION _____
DATE REINVESTED _____ APPROVED _____ REJECTED _____

Notes: _____
Give Pipe _____
Type Pipe _____
Basement Yes ☒ No ☐
Sewer Line Yes ☒ No ☐
Downspout to Street Yes ☒ No ☐
Septic Tank Buried 2' Below Yes ☐ No ☒
Contractor W. J. Ambrose
Special Conditions C.O. to B.C.
Other Notes _____

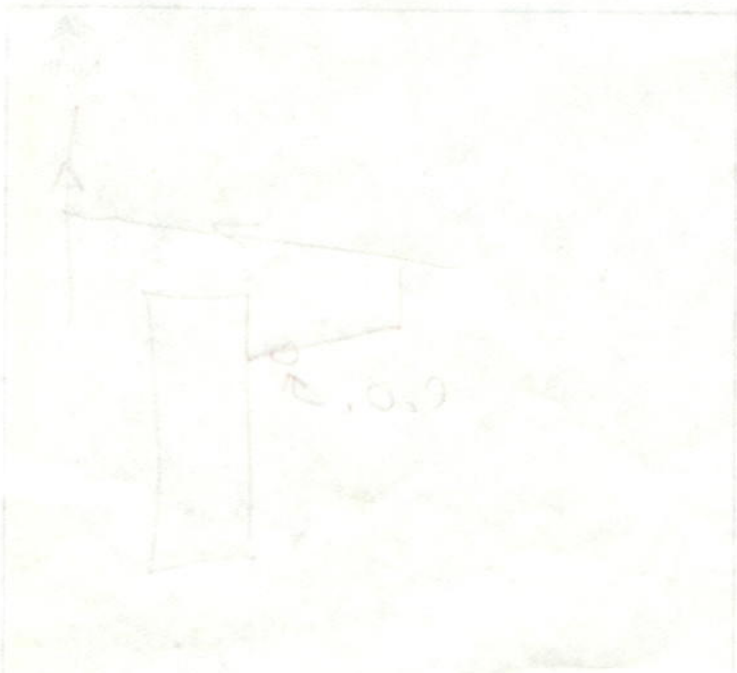

TO

WALTER JOHNSON

FROM

Fall Creek Regional Waste District

650 West - 1000 South

Pendleton, Indiana 46064

SUBJECT

BUCH AMBROSIO

DATE 10/30/85

MESSAGE

INMAN ESTATES

THIS MAN SAID THAT IN
A R/W SETTLEMENT, HE WAS
GIVEN A FREE TAP-ON, IS THIS
YOUR UNDERSTANDING? PLEASE ADVISE

SIGNED

Dad

REPLY

Dad:

Yes, Mr Ambrosio was granted a free
tap on as the sewer line went within
10 feet of his trailer.

SIGNED

Walter Johnson

DATE

11/5/85

Fall Creek Regional Waste District
630 West - 1000 South
Pandemon, Indiana 46084

NOV 10 1995

DATE 10/30/95

SUBJECT

MESSAGE FROM

PROVER

REPLY

NOV 10 1995

PLEASE PRINT NAME AND ADDRESS
LAST 2 WILL BE RETURNED WITH REPLY

NOV 10 1995