

add order
on file

4507

9-22282.00

4507

9-22282.00

AGREEMENT FOR SANITARY SEWER SERVICE

This Agreement made and entered into this 14th day of August, 2001, between FALL CREEK REGIONAL WASTE DISTRICT ("District") and Randy Tomlin ("Applicant") regarding the provision of sanitary sewer service, and the assignment of capacity in, and connection to, the District's facilities for the premises located at 105 Shirley Lane.

NOW THEREFORE, the parties, in consideration of the mutual promises set out in this Agreement, the receipt and sufficiency of which is hereby acknowledged, agree as follows:

1. The Applicant agrees that all workmanship and materials shall conform to all District ordinances and the District's construction standards. District must accept and approve all work and materials before backfilling and final connection is made to the sewer mains. Any violation of this provision will cause all lines and appurtenances in violation to be removed and replaced at the Applicant's expense.
2. The District shall have the right to enter upon the Applicant's premises at all reasonable times to inspect, repair, or replace any equipment used in connection with the District's service or which has an impact on said service.
3. The Applicant shall be responsible for all monthly user rates, capacity charges, and tap fees. The failure to pay any rate charge or fee may result in a lien against the property and/or the termination of service to the property, the cost of which will be borne by Applicant, including, but not limited to, all attorney's fees and collection costs.
4. The District shall not be responsible for any damages as a result of any failure to supply service unless said damages are due to default, neglect or culpability on the part of the District.
5. If there is an available sanitary sewer within three hundred (300) feet of the property line, the property owner shall be required to connect to the District's sanitary sewer system.
6. The Applicant and District agree that the provision of sanitary sewer service touches and concerns the property and the terms of this Agreement bind the District and Applicant and their heirs, executors, administrators, personal representatives, successors, agents, attorneys, assigns, designees, and transferees.

The parties hereto have read and fully understand the above provisions and agree to comply with said provisions.

FALL CREEK REGIONAL WASTE DISTRICT
Signature Jan E. Carey

APPLICANT: Bene L. Thomas
Signature

[illegible]

SUBSCRIBED and sworn to before me this 14th day of August, 2001

My Commission Expires: 4-29-2009

Signature Jan E. Carey

Printed Jan E. Carey
Notary Public

Notary Public
Resident of Madison County

INSPECTOR B DATE INSPECTED 8-30-1 APPROVED ☒ REJECTED ☐

REASON FOR REJECTION _____

DATE REINSPECTED _____ APPROVED _____ REJECTED _____

NOTES:
SIZE PIPE 4" 1/2 TYPE PIPE PVC

BASEMENT YES ☒ NO

SUMP PUMP YES NO ☒

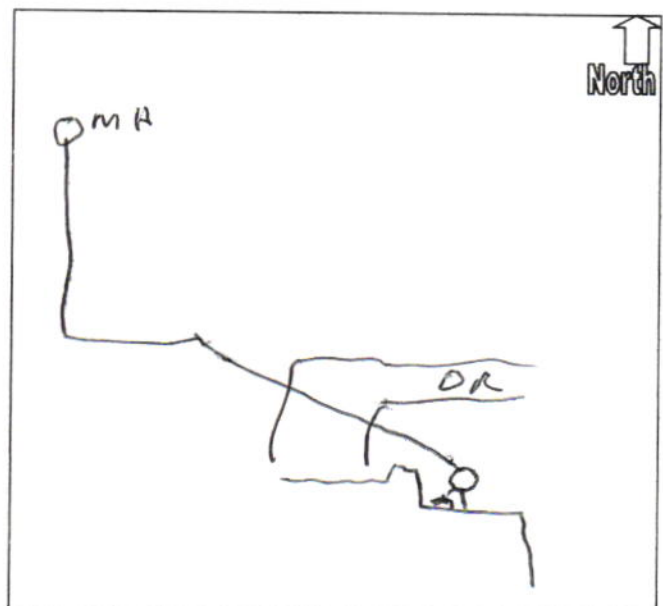
DOWNPOUT TO GROUND YES ☒ NO

SEPTIC TANK PUMPED & FILLED YES NO ☒

CONTRACTOR Dan Fessler

SPECIAL CONDITIONS

EXISTING HOME

NEW CONSTRUCTION 

TOOMBS PARRIGIN
MASONRY CONSTRUCTION INC
7220 S 675 W
PENDLETON IN 46064-9016

BUSINESS CREDIT LINE

1056

Date 8-14-01

6-12/410

Pay to the
order of

FCRWD

\$ 3,324.80

Three thousand three hundred twenty four and 80/100

Dollars  Security features
included.
Details on back.

National City
National City Bank
CLEVELAND, OHIO

NOT VALID FOR LESS THAN \$500.00

For Tap sewer

Bere' L Toombs

⑆041000124⑆

⑈ 1056

© Harland

