


Gidw.

PROJECT Phase II SHEET _____ OF _____

SUBJECT _____ DATE 8-10-18

JOB NO. 4447

BY Atlas

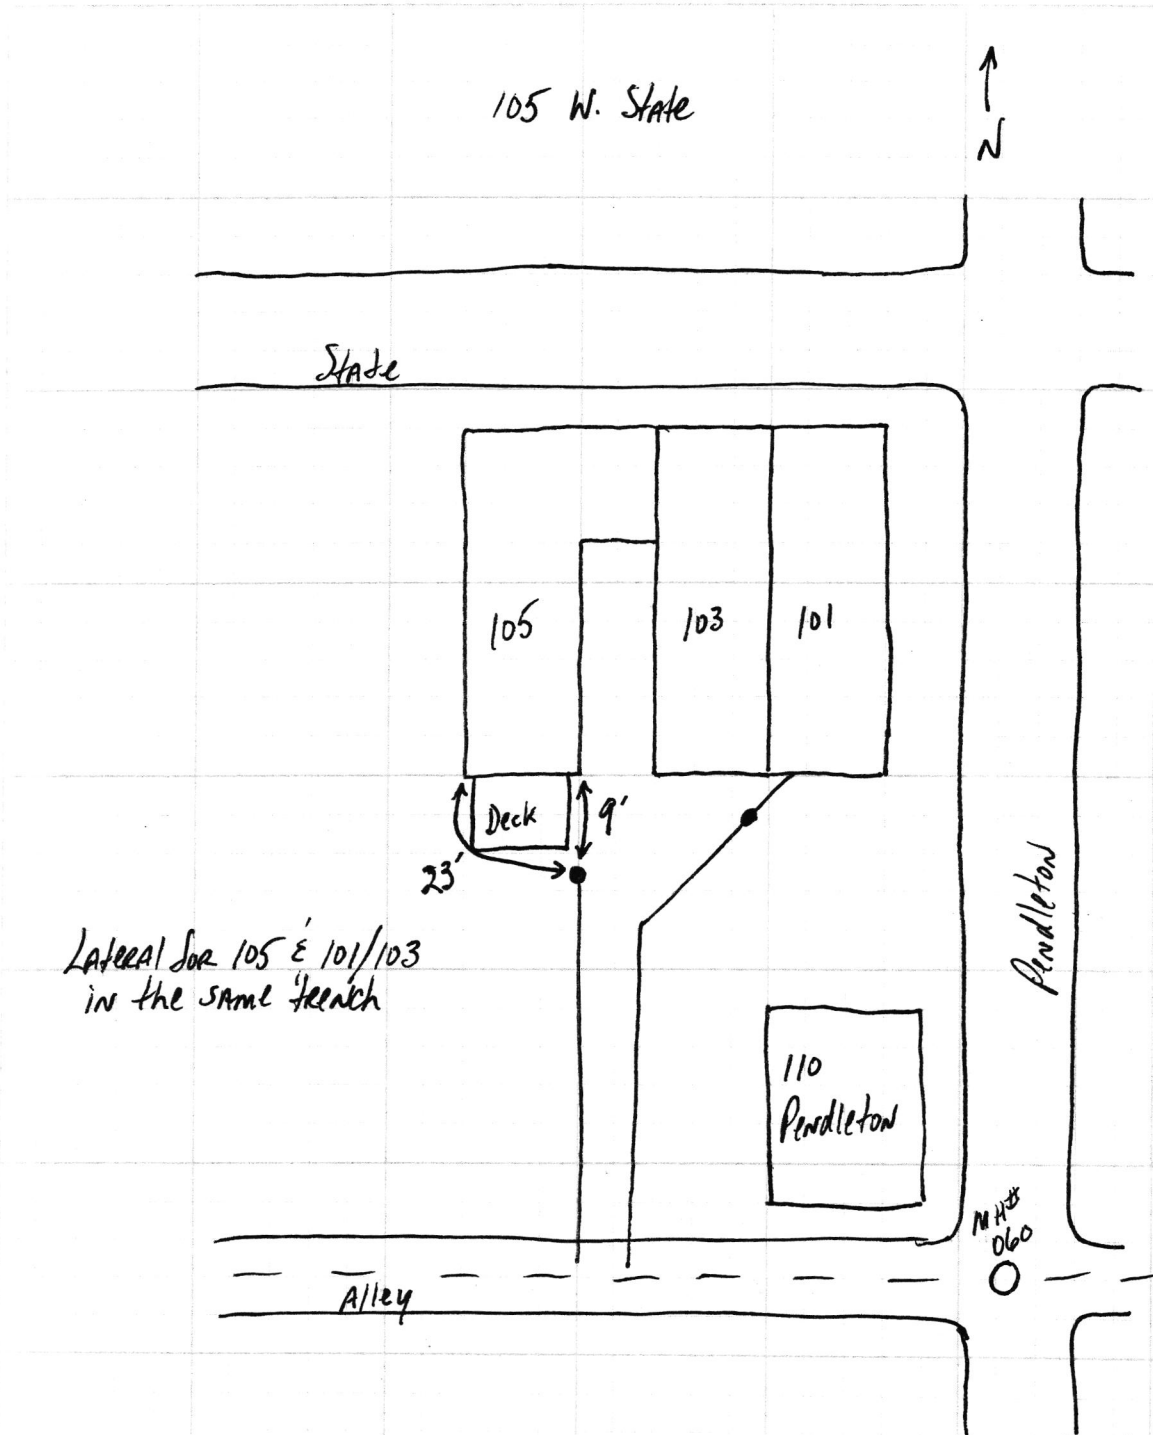

Lateral for 105 & 101/103
in the same trench

8:15:18

SKF Phase II

to give 01

