



FALL CREEK REGIONAL WASTE DISTRICT

9378 S. 650 West PO Box 59
Pendleton, IN 46064-0059 778-7544

add order
on file

26-05370.00

APPLICATION FOR SEWER PERMIT

Nº 2965

Date 11-29-00

Permit Void 90 days from Date of Issuance

Owner Name Gertrude Sanders

Property Address 10700 S. Lee St

Lot # _____ P.O. Box _____

Town Fortville, IN Zip Code 46040

Phone _____ City Water _____ Well _____

\$ N/A Tap on Fee Paid

\$ N/A Inspection fee paid

Application is hereby made for connection to the Fall Creek Regional Waste District Sewer System for the above listed property - Permit Type: Residential ☒, Commercial _____, Industrial _____, or Governmental/Institutional _____. User Information _____

All workmanship and materials shall conform to the standards of the District Ordinance as described in Ordinance 84-2 and 84-3 as amended. Acceptance and approval must be made by the District inspector or his duly authorized representative before backfilling and final connection is made to the main sewer lines. Any violation of applicable regulations will cause all lines and appurtenances in violation to be removed and replaced at the owners expense.

The Fall Creek Regional Waste District is responsible for the inspection, approval of materials, and installation techniques only. All costs for materials and installation and any liabilities resulting from same is the sole responsibility of the property owner.

I have read and fully understand the above provisions and agree to comply by said provisions.

APPLICANT(S) SIGNATURE

INSPECTOR Jim Alon

Date inspected 11-29-00 Approved ☒ Rejected _____

Reason for rejection _____

Date reinspected _____ Approved _____ Rejected _____

Notes:

Size Pipe 6"

Type Pipe DWC 26 160

Basement Yes _____ No _____

Sump Pump Yes _____ No _____

Downspout to Ground Yes _____ No _____


Septic Tank Pumped & filled ☒ Yes _____ No _____

Contractor Lowr/Koffner

Special Conditions _____

Existing Home ☒

New Construction _____

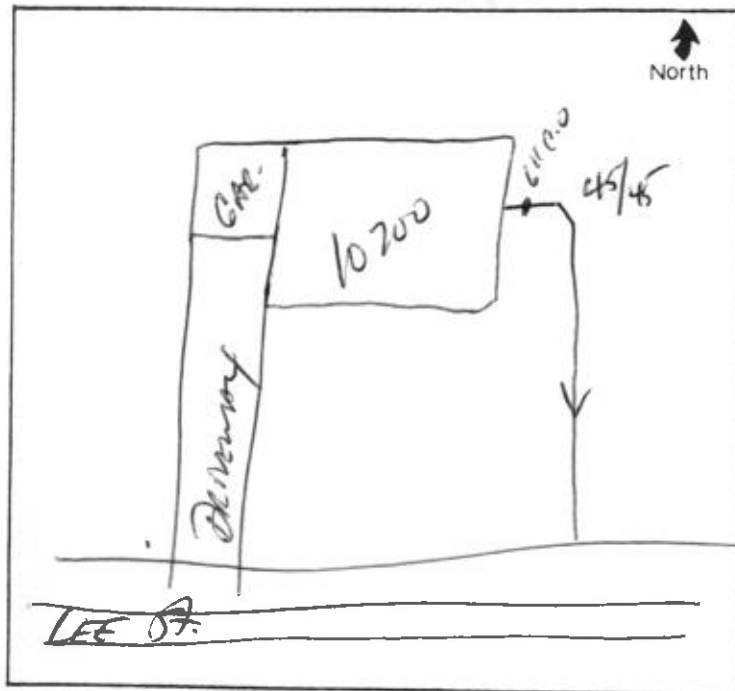

Justin Kopper called on 1/10/01
and tank had been
pumped & filled