


107 E State St.

o X Disconnected

Main Ext.

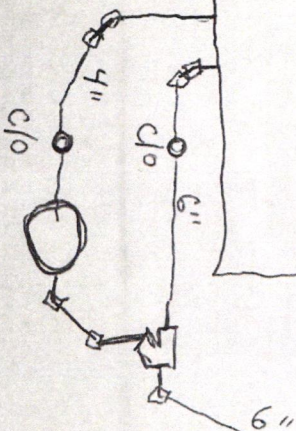

Fessler Exv.

12/21/23

→ N







Notes as of 2/28/2024

Being remodeled as a Pizza place

Old Madison County Glass shop

Acct #: 5-12087