



FALL CREEK REGIONAL WASTE DISTRICT

9378 S. 650 West PO Box 59
Pendleton, IN 46064-0059 778-7544

add order
on file

21-03516.00

APPLICATION FOR SEWER PERMIT

Nº 2446

Date 2/21/96 97

Permit Void 90 days from Date of Issuance

Owner Name J.R. HOSSLER

Property Address 59 INMAN Drive 107 Leatie Way (Canaan)

Lot # 67 54 P.O. Box _____

Town INGALLS, IN Zip Code 46048

Phone 317-641-7018 City Water X Well _____

\$ 700.00 Tap on Fee Paid

\$ _____ Inspection fee paid

Application is hereby made for connection to the Fall Creek Regional Waste District Sewer System for the above listed property - Permit Type: Residential X, Commercial _____, Industrial _____, or Governmental/Institutional _____. User Information _____.

All workmanship and materials shall conform to the standards of the District Ordinance as described in Ordinance 84-2 and 84-3 as amended. Acceptance and approval must be made by the District inspector or his duly authorized representative before backfilling and final connection is made to the main sewer lines. Any violation of applicable regulations will cause all lines and appurtenances in violation to be removed and replaced at the owners expense.

The Fall Creek Regional Waste District is responsible for the inspection, approval of materials, and installation techniques only. All costs for materials and installation and any liabilities resulting from same is the sole responsibility of the property owner.

I have read and fully understand the above provisions and agree to comply by said provisions.

Jeffrey R. Hessler
APPLICANT(S) SIGNATURE

INSPECTOR B

Date inspected 4-2-97 Approved ✓ Rejected _____

Reason for rejection _____

Date reinspected _____ Approved _____ Rejected _____

Notes:

Size Pipe 4 "

Type Pipe PVC

Basement Yes _____ No X

Sump Pump Yes _____ No X

Downspout to Ground Yes X No _____


Septic Tank Pumped & filled Yes _____ No X

Contractor A+A

Special Conditions _____

Existing Home _____

New Construction ✓

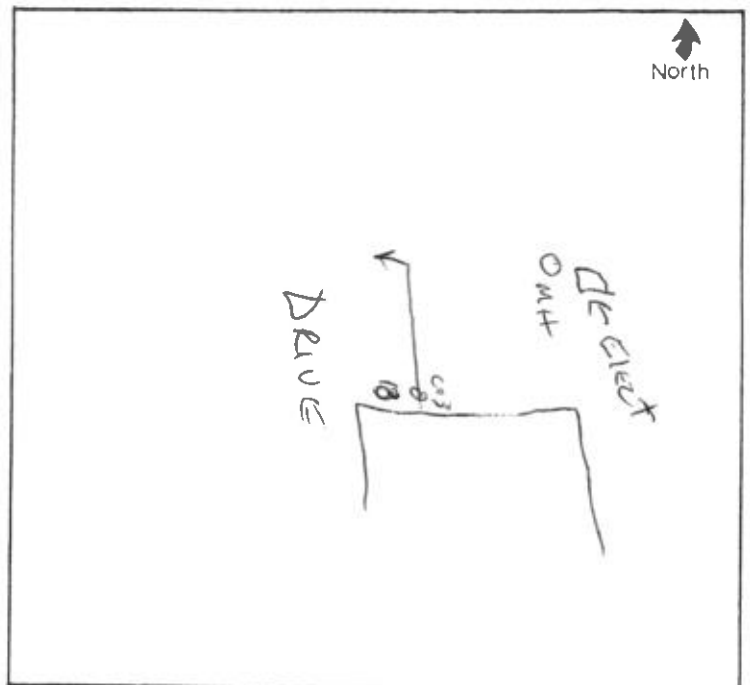

RECEIPT

FALL CREEK REGIONAL WASTE DISTRICT

P.O. BOX 59, CO. RD. 650 WEST

No 5746

gen FUND
PENDLETON, IN. 46064, 2-14 1997

536.10
600.40
400
19.00

RECEIVED FROM William J + Barbara Thomas \$ 2300.00
THE SUM OF Two thousand three hundred and 00/100 DOLLARS
ON ACCOUNT OF tap fee for 608 N. Pendleton Ave

PAID BY: CASH ☐ CHECK ☒ M.O. ☐

John E. Carey
AUTHORIZED SIGNATURE

PRESCRIBED BY STATE BOARD OF ACCOUNTS

GENERAL FORM NO. 322

RECEIPT

FALL CREEK REGIONAL WASTE DISTRICT

P.O. BOX 59, CO. RD. 650 WEST

No 5747

gen FUND
PENDLETON, IN. 46064, 2-14 1997

100.00

RECEIVED FROM Michael L. Roe / Mary Roe & Anna Ford \$ 25.00
THE SUM OF Twenty five dollars and 00/100 DOLLARS
ON ACCOUNT OF past sewer acct # 21-00325.00

PAID BY: CASH ☐ CHECK ☒ M.O. ☐

John E. Carey
AUTHORIZED SIGNATURE

PRESCRIBED BY STATE BOARD OF ACCOUNTS

GENERAL FORM NO. 322

RECEIPT

FALL CREEK REGIONAL WASTE DISTRICT

P.O. BOX 59, CO. RD. 650 WEST

No 5748

gen FUND
PENDLETON, IN. 46064, 2-21 1997

536.10

RECEIVED FROM Jeff Hossler / Southgate Homes \$ 700.00
THE SUM OF Seven hundred and 00/100 DOLLARS
ON ACCOUNT OF Lot #54 Inman Estates
Tap Fee 107 Yeatie Way per Mark 3/13/97

PAID BY: CASH ☐ CHECK ☒ M.O. ☐

John E. Carey
AUTHORIZED SIGNATURE