

**Fall Creek Regional Waste District**

#7501

9378 S 650 W, P.O. Box 59, Pendleton, IN 46064

765-778-7544

**Agreement for Sanitary Sewer Service**

This Agreement made and entered into this 29 day of March, 2021, between Fall Creek Regional Waste District ("District") and Davis Homes ("Applicant") regarding the provision of sanitary sewer service, and the assignment of capacity in and connection to, the District's facilities for the premises located at Lot # 278.

Street Address: 10834 Spirit Lake Prairie Hollow

Now therefore, the parties, in consideration of the mutual promises set out in this Agreement, the receipt and sufficiency of which is hereby acknowledged, agree as follows:

1. The Applicant agrees that all workmanship and materials shall conform to all District ordinances and the District's construction standards. District must accept and approve all work and materials before backfilling and final connection is made to the sewer mains. Any violation of this provision will cause all lines and appurtenances in violation to be removed and replaced at the Applicant's expense.
2. The District shall have the right to enter upon the Applicant's premises at all reasonable times to inspect, repair, or replace any equipment used in connection with the District's service or which has an impact on said service.
3. The Applicant shall be responsible for all monthly user rates, capacity charges, and tap fees. The failure to pay any rate charge or fee may result in a lien against the property and/or the termination of service to the property, the cost of which will be borne by Applicant, including, but not limited to, all attorney's fees and collection costs.
4. The District shall not be responsible for any damages as a result of any failure to supply service unless said damages are due to default, neglect or culpability on the part of the District.
5. If there is an available sanitary sewer within three hundred (300) feet of the property line, the property owner shall be required to connect to the District's sanitary sewer system.
6. The Applicant and District agree that the provision of sanitary sewer service touches and concerns the property and the terms of this Agreement bind the District and Applicant and their heirs, executors, administrators, personal representatives, successors, agents, attorneys, assigns, designees, and transferees.

The parties hereto have read and fully understand the above provisions and agree to comply with said provisions.

FALL CREEK REGIONAL WASTE DISTRICT


Signature

APPLICANT

Signature

STATE OF INDIANA )  
 ) SS:  
 COUNTY OF MADISON )

SUBSCRIBED and sworn to before me this 29 day of March, 2021

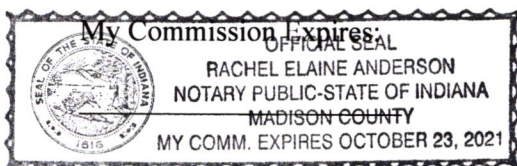

Signature

Printed

Notary Public

Resident of Madison County

\*\*\*\*\*

Inspector Kyle Date Inspected 10/22/21 Approved ✓ Rejected \_\_\_\_\_

Reason for Rejection \_\_\_\_\_


Date Reinspected \_\_\_\_\_ Approved \_\_\_\_\_ Rejected \_\_\_\_\_

## Notes:

Size Pipe 6" Type Pipe SDR 35Basement Yes (No)Sump Pump Yes (No)Downspout to Ground Yes (No)Septic Tank Pumped & Filled Yes (No)Contractor Statement Ex.

Special Conditions \_\_\_\_\_

Existing Home \_\_\_\_\_

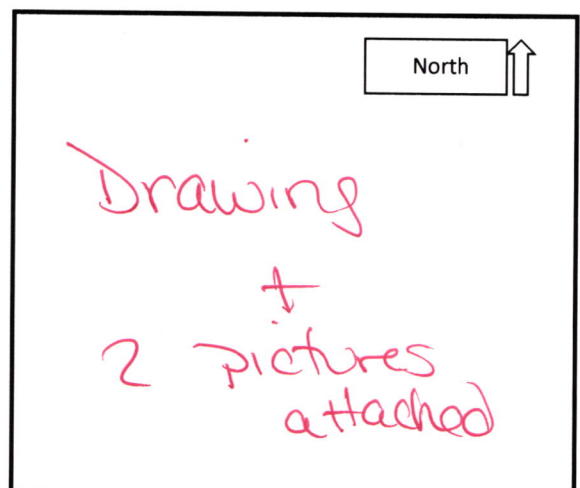New Construction ✓





(PIN)

JOB ID PHOLLOW3.278

CONTROL# 96890 DAV

10834 SPIRIT DRIVE  
INGALLS, IN 46048

$$1'' = 30'$$

**LOT AREA: 4,500 Sq. Ft.**

**LEGEND:**

LEGEND:

XX.X	PROPOSED GRADE PER PLAN
XX.XAB	AS BUILT GRADE

— — — S.S.D. — — — SUB-SURFACE DRAIN  
 ————— SANITARY SEWER  
 ————— ASL ————— 6" AS BUILT SANITARY LATERAL  
 ————— PSL ————— 6" PROPOSED SANITARY LATERAL  
 ————— STORM SEWER  
 ————— W ————— 3/4" WATER CONNECTION  
 ————— W ————— WATER MAIN  
 ————— • • • • ————— SWALE

**SANITARY MANHOLE**


 STORM MANHOLE

CURB INLET

 FIRE HYDRANT

D.U.&S.E.	DRAINAGE, UTILITY & SEWER EASEMENT
D.U.S.E.	DRAINAGE & SEWER EASEMENT

D.&S.E.	DRAINAGE & SEWER EASEMENT
L.E.	LANDSCAPE EASEMENT
B.L.	BUILDING LINE

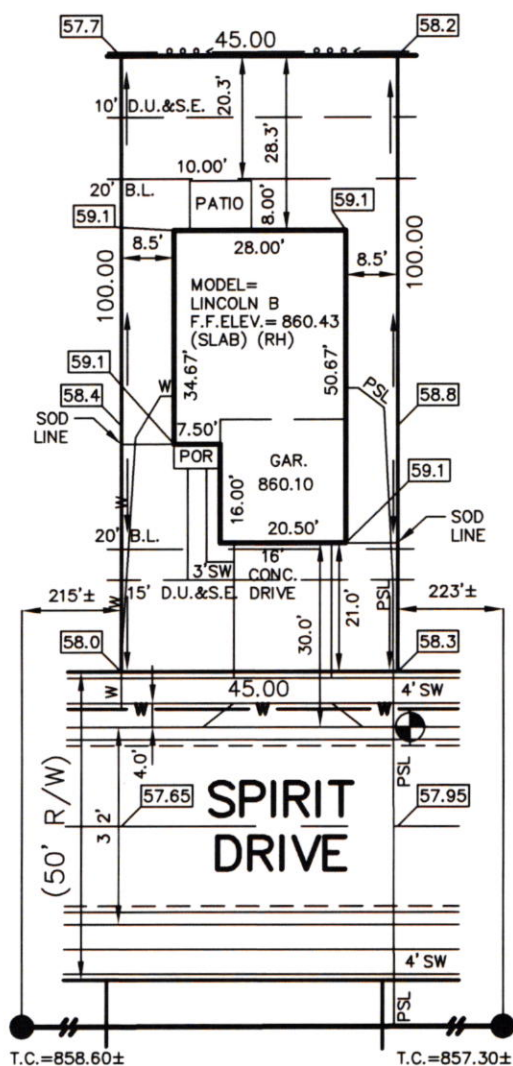

ALL UNDERGROUND SEWERS AND UTILITIES  
SHOWN ARE PLOTTED BY SCALE FROM  
DESIGN PLANS FURNISHED BY ENGINEER  
THE ACTUAL FIELD LOCATION MAY VARY.

BENCHMARK  
TOP OF CURB = 857.95

SOD:	893 ±	Sq. Ft.
SEEDING:	1,920 ±	Sq. Ft.
CONC. DRIVEWAY:	500 ±	Sq. Ft.
PRIVATE WALK:	68 ±	Sq. Ft.
PUBLIC WALK:	116 ±	Sq. Ft.

LOT 278  
PRAIRIE HOLLOW  
SECTION 3

INST. #2006008060

5' MINIMUM SIDE YARD  
10' MINIMUM AGGREGATE  
20' MINIMUM FRONT YARD  
20' MINIMUM REAR YARD



David J. Stoppelwerth

NOTE: ✓ THIS DRAWING IS NOT INTENDED TO BE REPRESENTED AS A RETRACEMENT OR ORIGINAL BOUNDARY SURVEY, A ROUTE SURVEY OR A SURVEYOR LOCATION REPORT.

03/15/21 JRS






Prairie Hollow Lot #278

10/22/21

N ←

Statement Exe

10834 Spirit Dr.

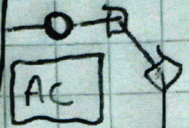











**Davis Building Group, LLC**3950 Priority Way S. Dr. Ste 210  
Indianapolis, IN 46240  
317-663-8340**Greenfield Banking Company**Greenfield, IN 46140  
71-367/749

15087

03/22/2021

Fall Creek Regional Waste District

\*\*\*\*\*4,160.00

PAY TO THE  
ORDER OF\*\*\*\*\***FOUR THOUSAND ONE HUNDRED SIXTY AND 00/100 DOLLARS**\*\*\*\*\*

\$

DOLLARS

PROTECTED AGAINST FRAUD

Fall Creek Regional Waste District

9378 S. 650 W

P.O. Box 59

Pendleton, IN 46064-0059

MEMO

Rec # 011625