


№ 5204

765-778-7544

21-20235.00

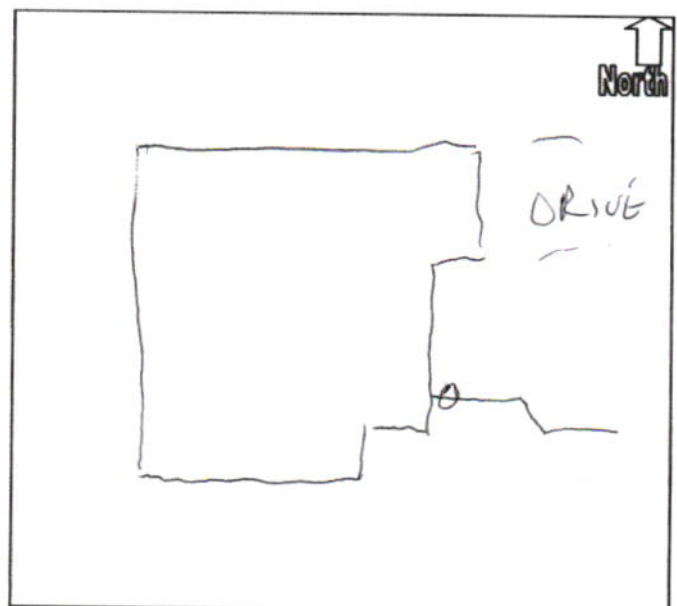

32239

C.P. MORGAN COMMUNITIES, LP  
CONSTRUCTION ACCOUNT

BANK ONE, NA  
INDIANAPOLIS, INDIANA 46277  
20-1-740

5/10/2004

PAY TO THE ORDER OF Fall Creek Regional Waste Dist

\*\*\*2,635.00

Two Thousand Six Hundred Thirty-Five and no/100\*\*\*\*\*  
DOLLARS

MEMO 107046102 PH 46 Robert Smith  
⑈032239⑈ ⑈074000010⑈

*Jonny Harris*

Details on back.  
Security Features Included.