


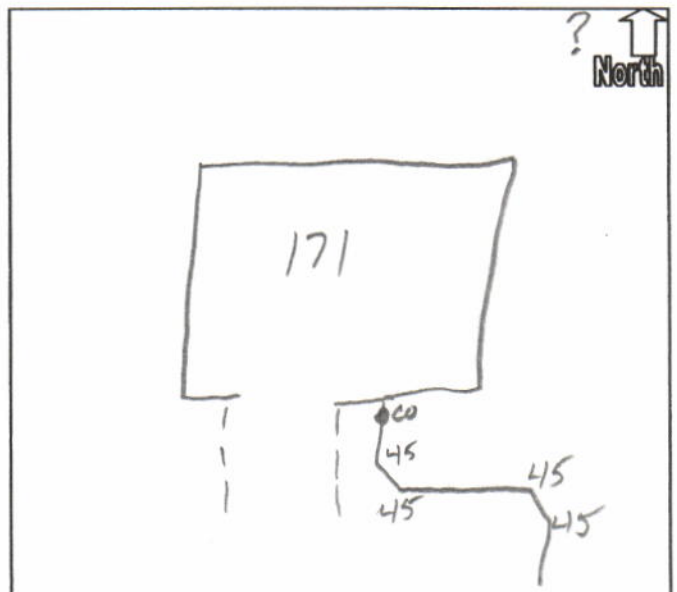

39377

C.P. MORGAN COMMUNITIES, LP
CONSTRUCTION ACCOUNT

JPMORGAN CHASE BANK, N.A.
INDIANAPOLIS, INDIANA 46277
20-1-740

10/26/2005

PAY TO THE ORDER OF Fall Creek Regional Waste Dist
One Thousand Four Hundred Twenty-Five and no/100 *****
Fall Creek Regional Waste Dist
\$ ***1,425.00
DOLLARS

MEMO 171
PH 168, sub 22 + 561

⑈039377⑈ ⑆074000010⑆

Jennifer Hedges