


Gidw.

PROJECT Phase II SHEET _____ OF _____
SUBJECT _____ DATE 5-11-18
JOB NO 4447
BY Atlas

108 S. MAIN

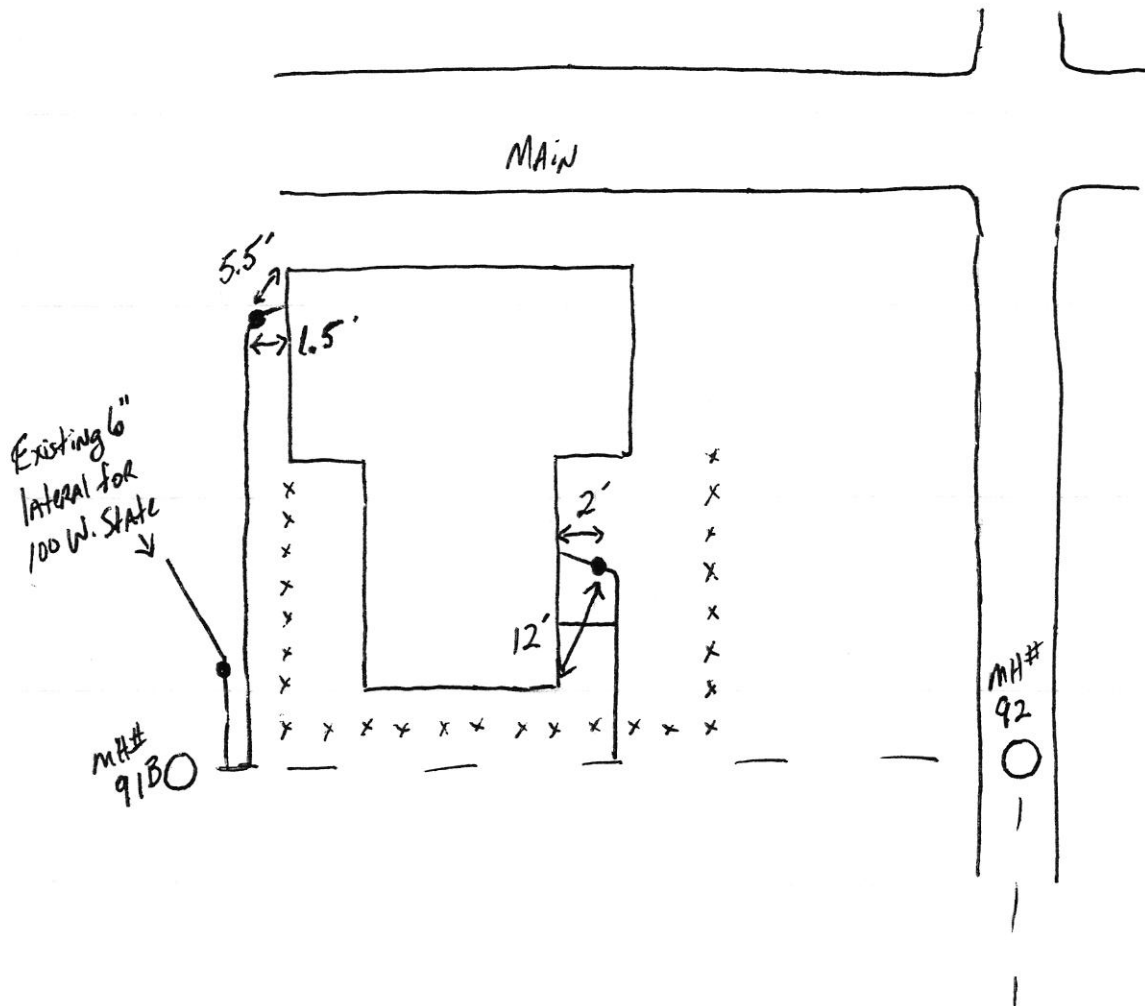

108 S Main ST

SPE Phase II

5-22-18



108 S Main

SRE Phase II

5/14/18

