



# FALL CREEK REGIONAL WASTE DISTRICT

Box 44, Pendleton, Indiana 46064

22-02145.00

Nº 001783

## APPLICATION FOR SEWER PERMIT

Permit No. \_\_\_\_\_ Date 5-6-91  
Permit Void 90 days from Date of Issuance  
Owner Name Edwards, Kent  
Property Address 108 Westbury Dr.  
Lot # 18 P.O. Box \_\_\_\_\_  
Town Pendleton, IN Zip Code 46064  
Phone \_\_\_\_\_ Water Meter \_\_\_\_\_  
\$ 500.00 Tap on Fee Paid  
\$ 25.00 Inspection fee paid

Application is hereby made for connection to the Fall Creek Regional Waste District Sewer System for the above listed property - Permit Type: Residential ☒, Commercial \_\_\_\_\_, Industrial \_\_\_\_\_, or Governmental/Institutional \_\_\_\_\_. User Information \_\_\_\_\_.

All workmanship and materials shall conform to the standards of the District Ordinance as described in Ordinance 84-2 and 84-3 as amended. Acceptance and approval must be made by the District inspector or his duly authorized representative before backfilling and final connection is made to the main sewer lines. Any violation of applicable regulations will cause all lines and appurtenances in violation to be removed and replaced at the owners expense.

The Fall Creek Regional Waste District is responsible for the inspection, approval of materials, and installation techniques only. All costs for materials and installation and any liabilities resulting from same is the sole responsibility of the property owner.

I have read and fully understand the above provisions and agree to comply by said provisions.

Kent Edwards  
APPLICANT(S) SIGNATURE

\*\*\*\*\*


INSPECTOR Don

Date inspected 5-6-91 Approved ☒ Rejected \_\_\_\_\_

Reason for rejection \_\_\_\_\_

Date reinspected \_\_\_\_\_ Approved \_\_\_\_\_ Rejected \_\_\_\_\_

Notes:  
Size Pipe 6"  
Type Pipe PVC  
Basement Yes \_\_\_\_\_ No ☒  
Sump Pump Yes \_\_\_\_\_ No ☒  
Downspout to Ground Yes \_\_\_\_\_ No \_\_\_\_\_  
Septic Tank Pumped & filled Yes \_\_\_\_\_ No \_\_\_\_\_  
Contractor Ron Rhon  
Special Conditions 6/98 Cobay

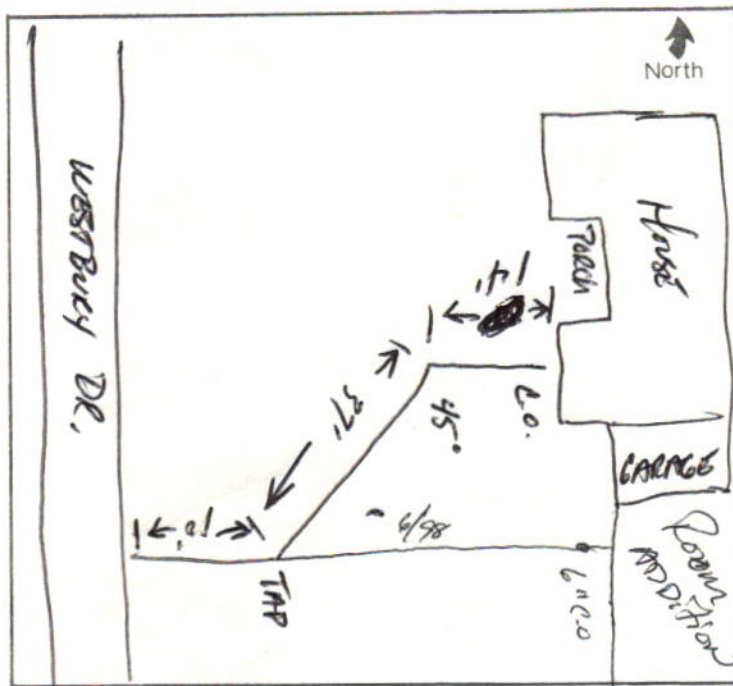

add order  
on file



FALL CREEK REGIONAL WASTE DISTRICT

9378 S. 650 West PO Box 59  
Pendleton, IN 46064-0059 778-7544

22-02145.01

APPLICATION FOR SEWER PERMIT

No 2046

Date 4/14/94

Permit Void 90 days from Date of Issuance

Owner Name Hallmark Homes

Property Address

N. Westbury

Lot # 17 - Falconhurst

P.O. Box

Town Pendleton

IN Zip Code

Phone

City Water

Well ☒

\$ 700.00

Tap on Fee Paid

\$ 25.00

Inspection fee paid

Application is hereby made for connection to the Fall Creek Regional Waste District Sewer System for the above listed property - Permit Type: Residential ☒, Commercial ☐, Industrial ☐, or Governmental/Institutional ☐. User Information

All workmanship and materials shall conform to the standards of the District Ordinance as described in Ordinance 84-2 and 84-3 as amended. Acceptance and approval must be made by the District inspector or his duly authorized representative before backfilling and final connection is made to the main sewer lines. Any violation of applicable regulations will cause all lines and appurtenances in violation to be removed and replaced at the owners expense.

The Fall Creek Regional Waste District is responsible for the inspection, approval of materials, and installation techniques only. All costs for materials and installation and any liabilities resulting from same is the sole responsibility of the property owner.

I have read and fully understand the above provisions and agree to comply by said provisions.

APPLICANT(S) SIGNATURE

INSPECTOR

Date inspected

Approved

Rejected

Reason for rejection

Date reinspected

Approved

Rejected

Notes:

Size Pipe

Type Pipe

Basement Yes

No

Sump Pump Yes

No

Downspout to Ground Yes

No

Septic Tank Pumped & filled Yes

No

Contractor

Special Conditions

Existing Home

New Construction

