## FALL CREEK REGIONAL WASTE DISTRICT

9378 S 650 WEST, P.O. BOX 59, PENDLETON, IN 46064


Brenner sh

Nº 6277

AGREEMENT FOR SANITARY SEWER SERVICE ROBERT 5 Kr
This Agreement made and entered into this and day of September, 200, between FALL CREEK REGIONAL WASTE DISTRICT ("District") and Congan ("Applicant") regarding the provision of sanitary sewer service, and the assignment of capacity in, and connection to, the District's facilities for the premises located at Collection 104 326
<b>NOW THEREFORE</b> , the parties, in consideration of the mutual promises set out in this Agreement, the receipt and sufficiency of which is hereby acknowledged, agree as follows:
<ol> <li>The Applicant agrees that all workmanship and materials shall conform to all District ordinances and the District's construction standards. District must accept and approve all work and materials before backfilling and final connection is made to the sewer mains. Any violation of this provision will cause all lines and appurtenances in violation to be removed and replaced at the Applicant's expense.</li> </ol>
<ol> <li>The District shall have the right to enter upon the Applicant's premises at all reasonable times to inspect, repair, or replace any equipment used in connection with the District's service or which has an impact on said service.</li> </ol>
3. The Applicant shall be responsible for all monthly user rates, capacity charges, and tap fees. The failure to pay any rate charge or fee may result in a lien against the property and/or the termination of service to the property, the cost of which will be borne by Applicant, including, but not limited to, all attorney's fees and collection costs
<ol> <li>The District shall not be responsible for any damages as a result of any failure to supply service unless said damages are due to default, neglect or culpability on the part of the District.</li> </ol>
<ol> <li>If there is an available sanitary sewer within three hundred (300) feet of the property line, the property owner shall be required to connect to the District's sanitary sewer system.</li> </ol>
6. The Applicant and District agree that the provision of sanitary sewer service touches and concerns the property and the terms of this Agreement bind the District and Applicant and their heirs, executors, administrators, personal representatives, successors, agents, attorneys, assigns, designees, and transferees.
The parties hereto have read and fully understand the above provisions and agree to comply with said provisions.
Signature  APPLICANT  Signature  Signature  Signature
STATE OF INDIANA ) ) SS: COUNTY OF MADISON)
SUBSCRIBED and sworn to before me this 21st day of September, 200 7.  My Commission Expires:  Signature Publicant May 19, 2008
A Resident of Printed  Madison County, Indiana Notary Public  Rebecca A. McClintick, Notary Public Resident of Madison County
NSPECTOR SN DATE INSPECTED 19/107 APPROVED REJECTED
REASON FOR REJECTION
DATE REINSPECTEDAPPROVEDREJECTED
NOTES: 6" TYPE PIPE 35
BASEMENT YES NO
LIMP PLIMP VES. NO.

DOWNSPOUT TO GROUND YES NO SEPTIC TANK PUMPED & FILLED YES CONTRACTOR SPECIAL CONDITIONS EXISTING HOME

NEW CONSTRUCTION 6

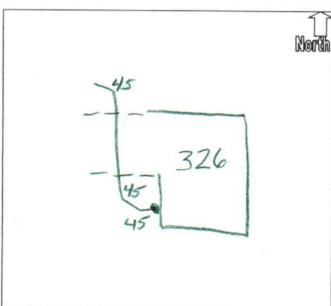

C.P. MORGAN COMMUNITIES, LP

JPMORGAN CHASE BANK, N.A. INDIANAPOLIS, INDIANA 46277 20-1-740

9/20/07

PAY TO THE Fall Creek Regional Wastewater

\$950. 1100

\_DOLLARS

MEMO PH 3264 PH 254

"O43702" I

1

William Market M