



FALL CREEK REGIONAL WASTE DISTRICT

9378 S. 650 West PO Box 59
Pendleton, IN 46064-0059 778-7544

9-19440.00

APPLICATION FOR SEWER PERMIT

Nº 2755

Date

4/18/00

Permit Void 90 days from Date of Issuance

Owner Name

Richard H. TRUNK (American Star Homes)

Property Address

1099 S. Pendleton IN 46064

Lot #

P.O. Box

Town

Pendleton

IN Zip Code

Phone

City Water

Well

\$ 2300.00

Tap on Fee Paid

\$

Inspection fee paid

Application is hereby made for connection to the Fall Creek Regional Waste District Sewer System for the above listed property - Permit Type: Residential ☒, Commercial ☐, Industrial ☐, or Governmental/Institutional ☐. User Information

All workmanship and materials shall conform to the standards of the District Ordinance as described in Ordinance 84-2 and 84-3 as amended. Acceptance and approval must be made by the District inspector or his duly authorized representative before backfilling and final connection is made to the main sewer lines. Any violation of applicable regulations will cause all lines and appurtenances in violation to be removed and replaced at the owners expense.

The Fall Creek Regional Waste District is responsible for the inspection, approval of materials, and installation techniques only. All costs for materials and installation and any liabilities resulting from same is the sole responsibility of the property owner.

I have read and fully understand the above provisions and agree to comply by said provisions.

APPLICANT(S) SIGNATURE

INSPECTOR

Date inspected

4-14-00

Approved

Rejected

Reason for rejection

Date reinspected

Approved

Rejected

Notes:

Size Pipe

6" ID

Type Pipe

PVC

Basement Yes

No ☒

Sump Pump Yes

No ☒

Downspout to Ground Yes ☒ No

Septic Tank Pumped & filled Yes

No ☒


Contractor

American Star Homes

Special Conditions

Existing Home

New Construction ☒

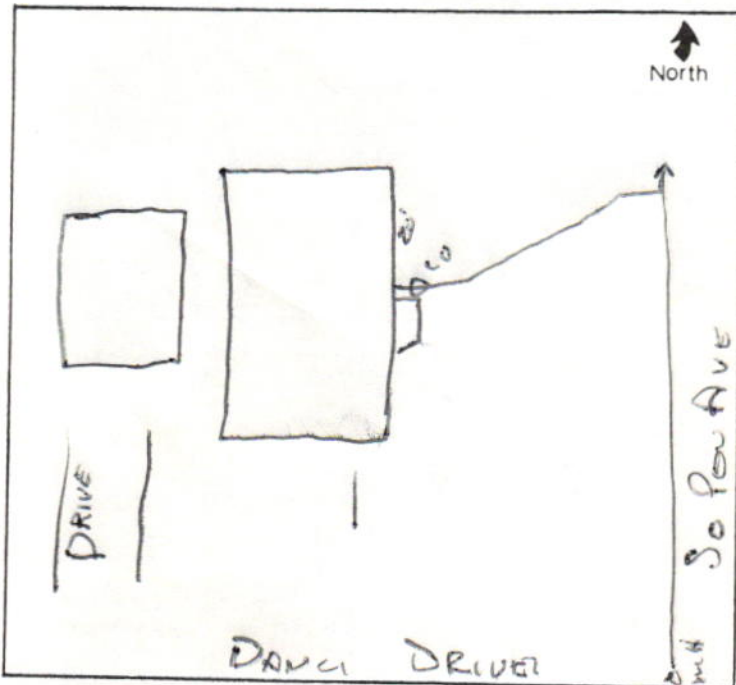

1559

AMERICAN STAR HOMES, INC

8454 SOUTH STATE RD 67
PENDLETON, IN 46064

DATE

4/18/00

20-7048-2740

PAY
TO THE
ORDER OFFall Creek Regional Water
Two Thousand Three Hundred 00/100

\$2,300.00

DOLLARS

 Security features
included.
Details on back.UNION FEDERAL BANK
INDIANAPOLIS, INDIANA 46204

FOR

HETRICK



MP

⑈001559⑈