

Gidw.

PROJECT

Phase II

SHEET

OF

SUBJECT

DATE

8-9-18

JOB NO

4447


BY

Atlas

109 W. State

↑
N

State

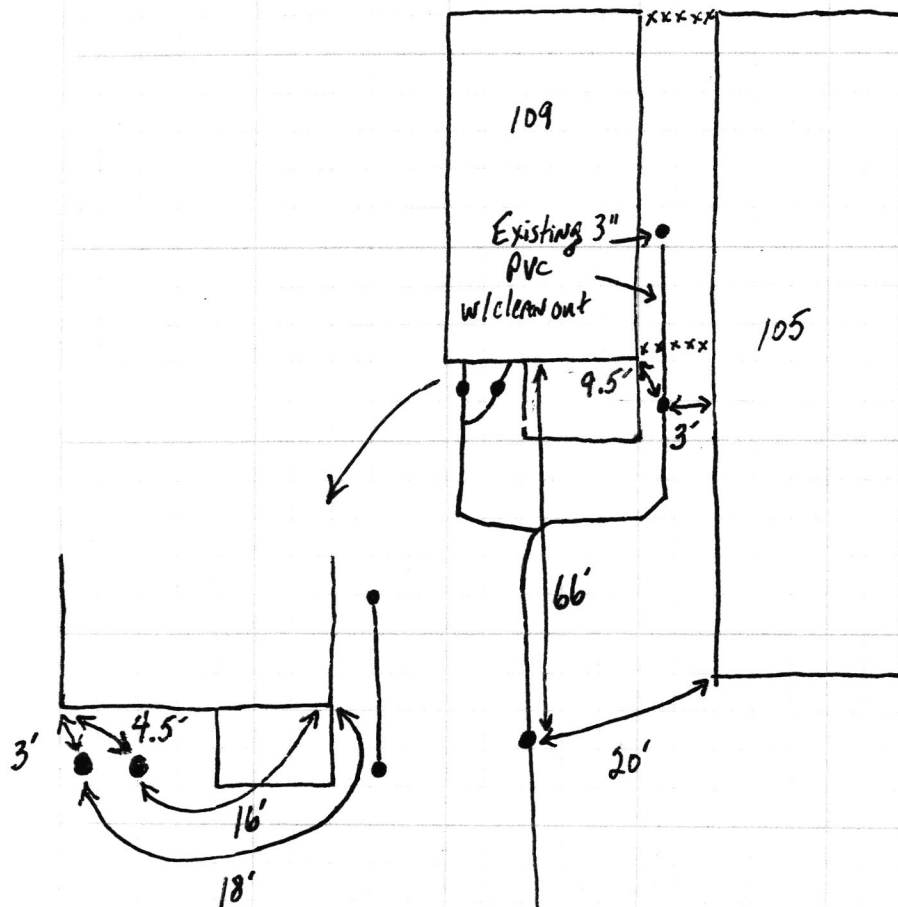





ON 1 inch 4

8-1518