

9378 S 650 WEST, P.O. BOX 59, PENDLETON, IN 46064

765-778-7544

AGREEMENT FOR SANITARY SEWER SERVICE

This Agreement made and entered into this 24 day of August, 2006 between FALL CREEK REGIONAL WASTE DISTRICT ("District") and Musby Builders ("Applicant") regarding the provision of sanitary sewer service, and the assignment of capacity in, and connection to, the District's facilities for the premises located at Lot 90 Bendle Point.

NOW THEREFORE, the parties, in consideration of the mutual promises set out in this Agreement, the receipt and sufficiency of which is hereby acknowledged, agree as follows:

1. The Applicant agrees that all workmanship and materials shall conform to all District ordinances and the District's construction standards. District must accept and approve all work and materials before backfilling and final connection is made to the sewer mains. Any violation of this provision will cause all lines and appurtenances in violation to be removed and replaced at the Applicant's expense.
2. The District shall have the right to enter the Applicant's premises at all reasonable times to inspect, repair, or replace any equipment or facilities used in connection with the District's service or which has an impact on said service.
3. The Applicant shall be responsible for payment of all capacity charges, and tap fees. The failure to pay any rate charge or fee in full shall constitute a breach of this Agreement and property, the cost of which will be borne by the Applicant. In the event of termination of service to the property, the cost of which will be borne by the Applicant, shall be limited to, all attorney's fees and collection costs.
4. The District shall not be responsible for any damages as a result of any failure to supply service unless said damages are due to default, neglect or culpability on the part of the District.
5. If there is an available sanitary sewer within three hundred (300) feet of the property line, the property owner shall be required to connect to the District's sanitary sewer system.
6. The Applicant and District agree that the provision of sanitary sewer service touches and concerns the property and the terms of this Agreement bind the District and Applicant and their heirs, executors, administrators, personal representatives, successors, agents, attorneys, assigns, designees, and transferees.

The parties hereto have read and fully understand the above provisions and agree to comply with said provisions.

FALL CREEK REGIONAL WASTE DISTRICT
Signature Rebecca Hunter

APPLICANT *Eph*
Signature

STATE OF INDIANA)
COUNTY OF MADISON) SS:

SUBSCRIBED and sworn to before me this 24th day of August, 2006

My Commission Expires: 4-19-2008

Signature Teresa K. Hutton

Printed Teresa K. Hutton

Notary Public
Resident of Madison County

INSPECTOR SN DATE INSPECTED 9/15/06 APPROVED ✓ REJECTED _____

REASON FOR REJECTION

DATE REINSPECTED _____ APPROVED _____ REJECTED _____

NOTES: SIZE PIPE 6" TYPE PIPE 35

BASEMENT YES NO

SUMP PUMP YES NO

DOWNSPOUT TO GROUND YES NO


SEPTIC TANK PUMPED & FILLED YES NO

CONTRACTOR Belton Ex

SPECIAL CONDITIONS

EXISTING HOME

NEW CONSTRUCTION ✓

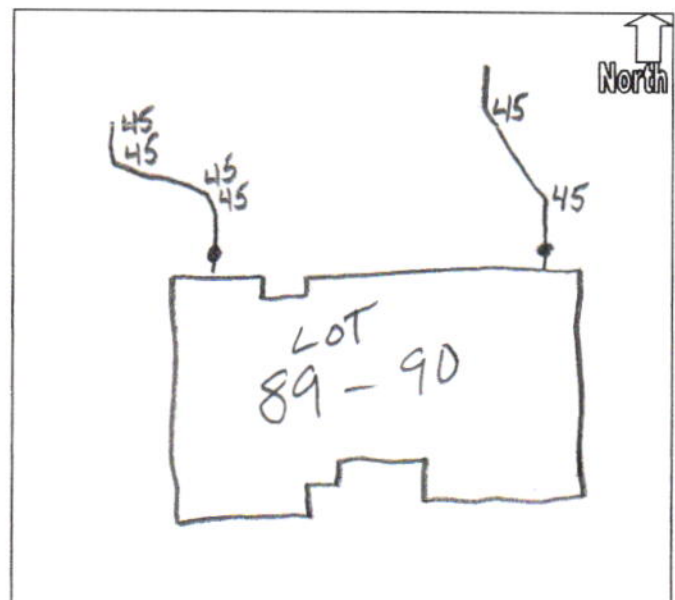



MUSTIN BUILDERS, INC.
810 CENTRAL AVENUE
ANDERSON, IN 46012
PH. 765-644-8502

KEYBANK NATIONAL ASSOCIATION
CLEVELAND, OHIO 44114

56-704-412

055548

Five Thousand Two Hundred Seventy ⁰⁰/₁₀₀

DATE

8-24-06

CHECK NO.

055548

AMOUNT

5270.⁰⁰/₁₀₀

PAY
TO THE
ORDER
OF

FALL CREEK REGIONAL WASTE


AUTHORIZED SIGNATURE

MP

⑈055548⑈