



Git

PROJECT Phase II
SUBJECT
DATE 8-21-18
JOB NO. 4447
BY Atlas

N
↓

110 1/2 W. High

Sits behind
110 E. High

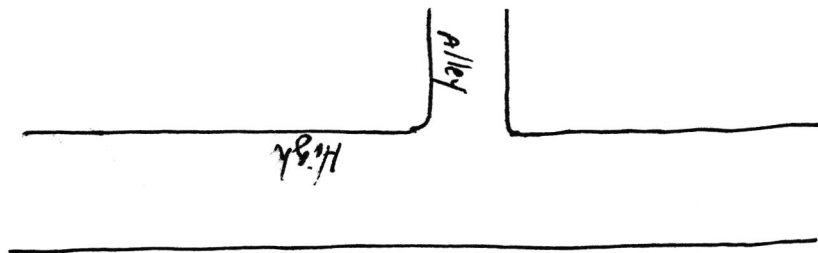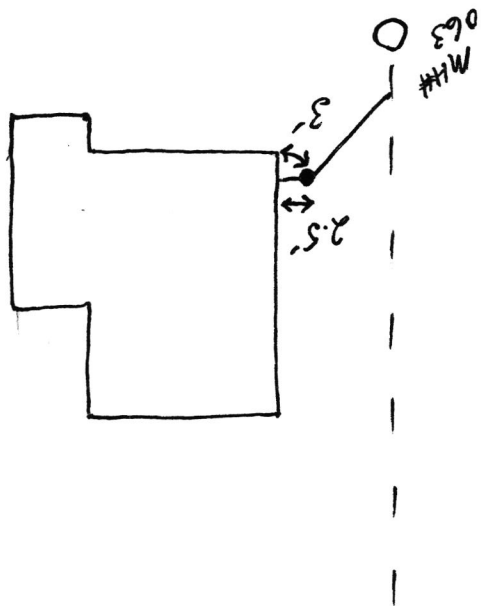

CHT Phase II

8.15.18

