



FALL CREEK REGIONAL WASTE DISTRICT

Box 44, Pendleton, Indiana 46064

2-0003900.00

Nº 001512

APPLICATION FOR SEWER PERMIT

Permit No. \_\_\_\_\_ Date 4-22-86  
Permit Void 90 days from Date of Issuance  
Owner Name Robert Albregts  
Property Address 1106 FALL CREEK OVERLOOK  
Lot # \_\_\_\_\_ P.O. Box \_\_\_\_\_  
Town Pendleton IN Zip Code 46064  
Phone 778-2844 Water Meter \_\_\_\_\_  
\$ 150.00 Tap on Fee Paid  
\$ 25.00 Inspection fee paid

Application is hereby made for connection to the Fall Creek Regional Waste District Sewer System for the above listed property - Permit Type: Residential ☒, Commercial \_\_\_\_\_, Industrial \_\_\_\_\_, or Governmental/Institutional \_\_\_\_\_. User Information \_\_\_\_\_.

All workmanship and materials shall conform to the standards of the District Ordinance as described in Ordinance 84-2 and 84-3 as amended. Acceptance and approval must be made by the District inspector or his duly authorized representative before backfilling and final connection is made to the main sewer lines. Any violation of applicable regulations will cause all lines and appurtenances in violation to be removed and replaced at the owners expense.

The Fall Creek Regional Waste District is responsible for the inspection, approval of materials, and installation techniques only. All costs for materials and installation and any liabilities resulting from same is the sole responsibility of the property owner.

I have read and fully understand the above provisions and agree to comply by said provisions.

Sandra Albregts

APPLICANT(S) SIGNATURE

\*\*\*\*\*


INSPECTOR TIM

Date inspected 4-25-86 Approved ☒ Rejected \_\_\_\_\_

Reason for rejection \_\_\_\_\_

Date reinspected \_\_\_\_\_ Approved \_\_\_\_\_ Rejected \_\_\_\_\_

Notes:  
Size Pipe 4"  
Type Pipe PVC  
Basement Yes \_\_\_\_\_ No ☒  
Sump Pump Yes \_\_\_\_\_ No ☒  
Downspout to Ground Yes ☒ No \_\_\_\_\_  
Septic Tank Pumped & filled Yes \_\_\_\_\_ No ☒  
Contractor Bill Regan  
Special Conditions \_\_\_\_\_

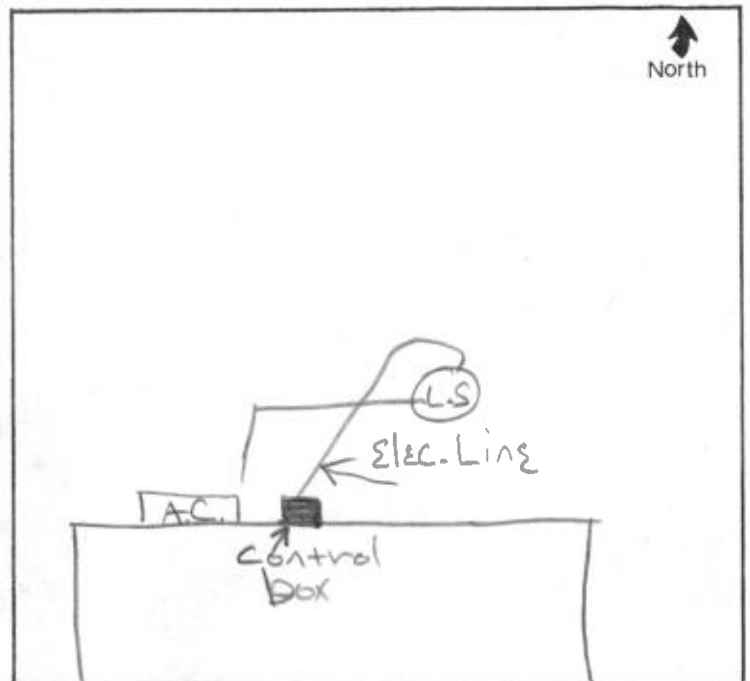

# FALL CREEK REGIONAL WASTE DISTRICT

Box 43 Pahrump, Nevada 89064



1-800-390-0000

NO 001213

DATE OF THIS ORDER

4-22-81

TO: Robert Albrecht  
 FROM: Fall Creek Regional Waste District  
 SUBJECT: Waste Transfer  
 ORDER NO: 778-2844  
 DATE: 4-22-81  
 QUANTITY: 120 cu yd  
 PRICE: \$2.00

THIS ORDER IS VALID FOR THE TRANSFER OF WASTE FROM THE FALL CREEK REGIONAL WASTE DISTRICT TO THE ABOVE NAMED PARTY. THE ORDER IS VALID FOR A PERIOD OF 90 DAYS FROM THE DATE OF ISSUANCE.


ALL WASTE MUST BE TRANSFERRED TO THE ABOVE NAMED PARTY IN ACCORDANCE WITH THE WASTE MANAGEMENT ACT. THE ORDER IS VALID FOR A PERIOD OF 90 DAYS FROM THE DATE OF ISSUANCE.

THE FALL CREEK REGIONAL WASTE DISTRICT IS RESPONSIBLE FOR THE PROPER DISPOSAL OF WASTE. THE ORDER IS VALID FOR A PERIOD OF 90 DAYS FROM THE DATE OF ISSUANCE.

IT IS THE POLICY OF THE FALL CREEK REGIONAL WASTE DISTRICT TO PROVIDE WASTE DISPOSAL SERVICES TO ALL RESIDENTS AND BUSINESSES IN THE AREA.

FOR MORE INFORMATION, PLEASE CONTACT THE FALL CREEK REGIONAL WASTE DISTRICT AT (775) 738-2844.

DATE ISSUED: 4-22-81  
 BY: TM

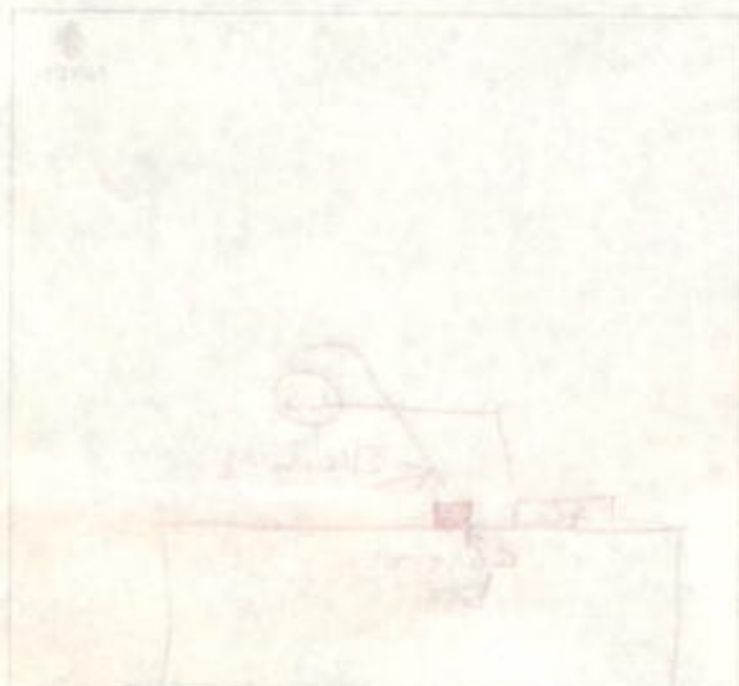

TO: Robert Albrecht  
 FROM: Fall Creek Regional Waste District  
 SUBJECT: Waste Transfer  
 ORDER NO: 778-2844  
 DATE: 4-22-81  
 QUANTITY: 120 cu yd  
 PRICE: \$2.00