



FALL CREEK REGIONAL WASTE DISTRICT

Box 44, Pendleton, Indiana 46064

20003630.00

Nº 001656

APPLICATION FOR SEWER PERMIT

Permit No. _____ Date 10-14-88
Permit Void 90 days from Date of Issuance
Owner Name BRUCE POSTON
Property Address 1106 Yellow Brick Road
Lot # 46 Yellow Brick Rd P.O. Box _____
Town PENDLETON, IN Zip Code 46064
Phone _____ Water Meter N/A
\$ 2,880.00 Tap on Fee Paid
\$ 25.00 Inspection fee paid

Application is hereby made for connection to the Fall Creek Regional Waste District Sewer System for the above listed property - Permit Type: Residential ☒, Commercial _____, Industrial _____, or Governmental/Institutional _____. User Information _____.

All workmanship and materials shall conform to the standards of the District Ordinance as described in Ordinance 84-2 and 84-3 as amended. Acceptance and approval must be made by the District inspector or his duly authorized representative before backfilling and final connection is made to the main sewer lines. Any violation of applicable regulations will cause all lines and appurtenances in violation to be removed and replaced at the owners expense.

The Fall Creek Regional Waste District is responsible for the inspection, approval of materials, and installation techniques only. All costs for materials and installation and any liabilities resulting from same is the sole responsibility of the property owner.

I have read and fully understand the above provisions and agree to comply by said provisions.

Michael J. Fox
APPLICANT(S) SIGNATURE


INSPECTOR B

Date inspected 11-22-88 Approved - Rejected _____

Reason for rejection _____

Date reinspected _____ Approved _____ Rejected _____

Notes:
Size Pipe 4' "
Type Pipe PVC
Basement Yes Y No _____
Sump Pump Yes _____ No X
Downspout to Ground Yes X No _____
Septic Tank Pumped & filled Yes _____ No X
Contractor Gould Plumbing
Special Conditions New Const.

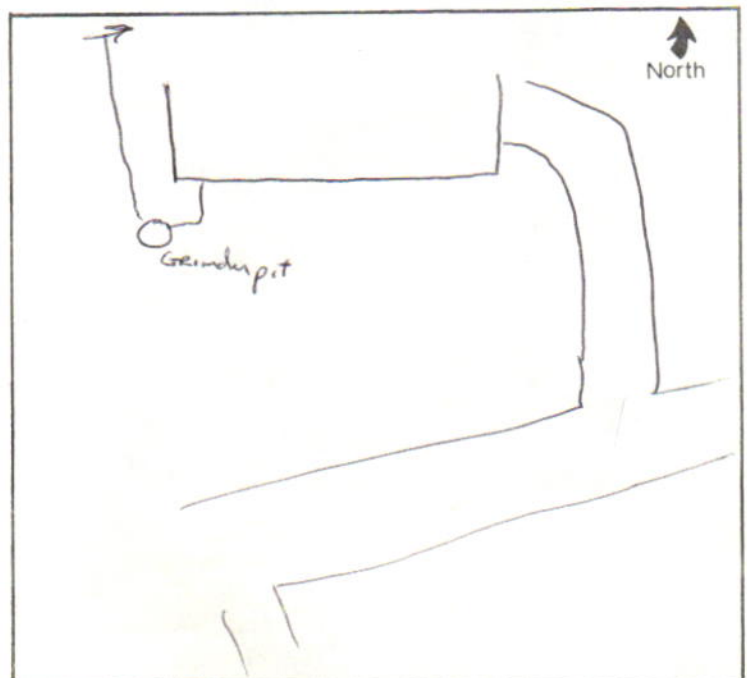

BENNETT & KIRITSIS, INC. 3-88
1135 BROADWAY PH. 644-5381
ANDERSON, IN 46012

1874

PAY
TO THE
ORDER OF

Fall Creek Valley Waste Water Treatment
10-3-1988 71-71/749
REGISTERED
BN468934 902905 DOLLARS CTS \$ 2905.00

**ANDERSON BANKING
COMPANY**
931 MERCANT PLAZA, ANDERSON, INDIANA 46016
A MERCHANTS NATIONAL COMPANY

DOLLARS

FOR

Kim R. Cooper

⑈001874⑈