



FALL CREEK REGIONAL WASTE DISTRICT

Box 44, Pendleton, Indiana 46064

2-000 3860.00

Nº 001511

APPLICATION FOR SEWER PERMIT

Permit No. _____ Date April 22, 1986
Permit Void 90 days from Date of Issuance
Owner Name Neil Cisewski
Property Address 1107 Fall Creek Overlook
Lot # _____ P.O. Box _____
Town Pendleton, IN Zip Code 46064
Phone 778-4086 Water Meter _____
\$ 150.00 Tap on Fee Paid
\$ 2500 Inspection fee paid

Application is hereby made for connection to the Fall Creek Regional Waste District Sewer System for the above listed property - Permit Type: Residential X, Commercial _____, Industrial _____, or Governmental/Institutional _____. User Information _____.

All workmanship and materials shall conform to the standards of the District Ordinance as described in Ordinance 84-2 and 84-3 as amended. Acceptance and approval must be made by the District inspector or his duly authorized representative before backfilling and final connection is made to the main sewer lines. Any violation of applicable regulations will cause all lines and appurtenances in violation to be removed and replaced at the owners expense.

The Fall Creek Regional Waste District is responsible for the inspection, approval of materials, and installation techniques only. All costs for materials and installation and any liabilities resulting from same is the sole responsibility of the property owner.

I have read and fully understand the above provisions and agree to comply by said provisions.

X Bill Regan
APPLICANT(S) SIGNATURE


INSPECTOR TIM

Date inspected 4-25-86 Approved X Rejected _____

Reason for rejection _____

Date reinspected _____ Approved _____ Rejected _____

Notes:
Size Pipe 4"
Type Pipe PVC
Basement Yes _____ No X
Sump Pump Yes _____ No X
Downspout to Ground Yes No _____
Septic Tank Pumped & filled Yes _____ No X
Contractor Bill Regan
Special Conditions _____

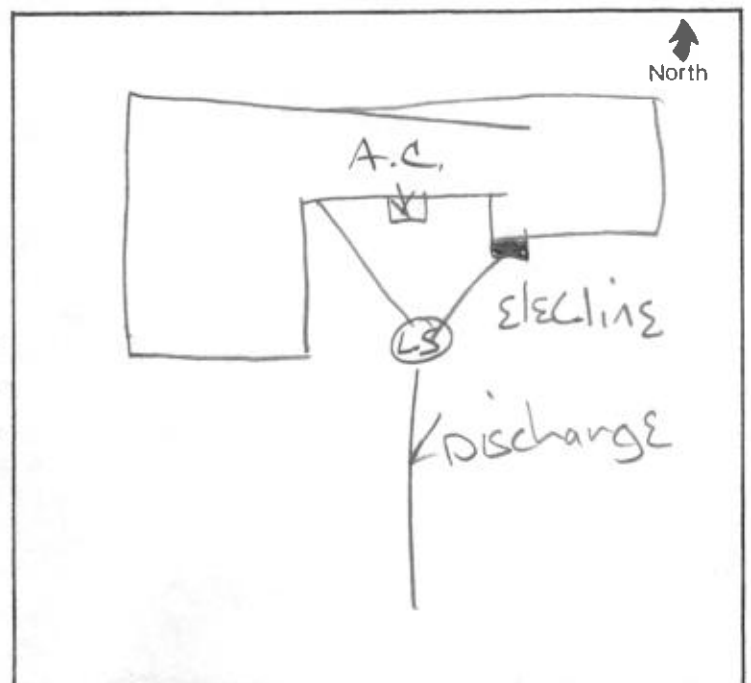

115100 %



