

Gidw.

PROJECT

Phase II

SHEET

OF

SUBJECT

DATE

7-9-18

JOB NO.


4447

BY

Atlas

110 S. East

N
↓

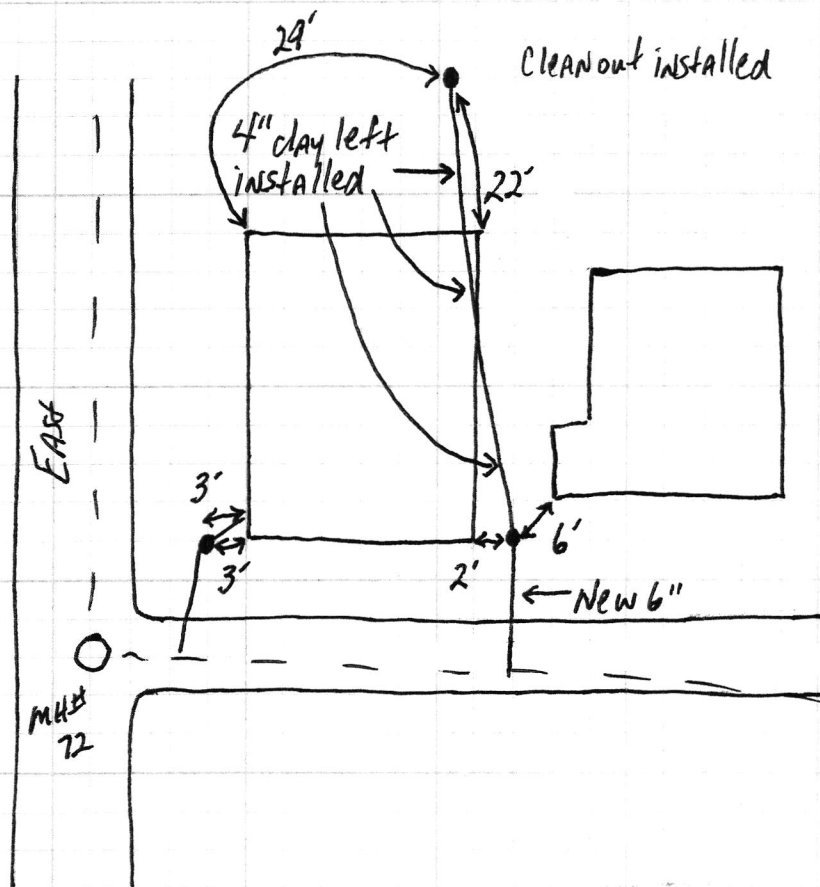

110 East

S&P Phase II

7.11.18



110
110 S East ST

Srf Phase II

7.11.18



110 S East

Spr Phase II

7.11.18

