

Gidw.

PROJECT Phase II SHEET _____ OF _____



SUBJECT _____ DATE 8-4-18

JOB NO 4447

BY Atlas

110 W. High

↑
N

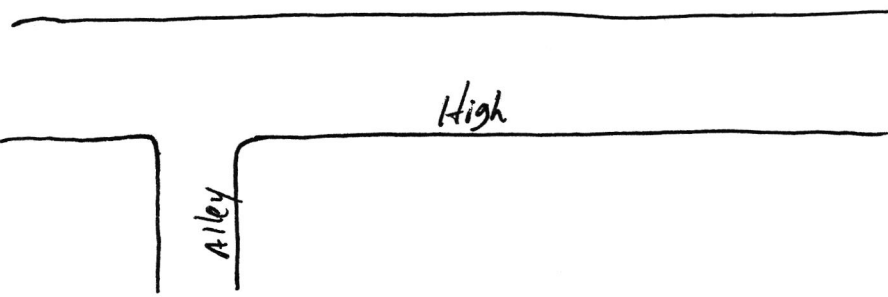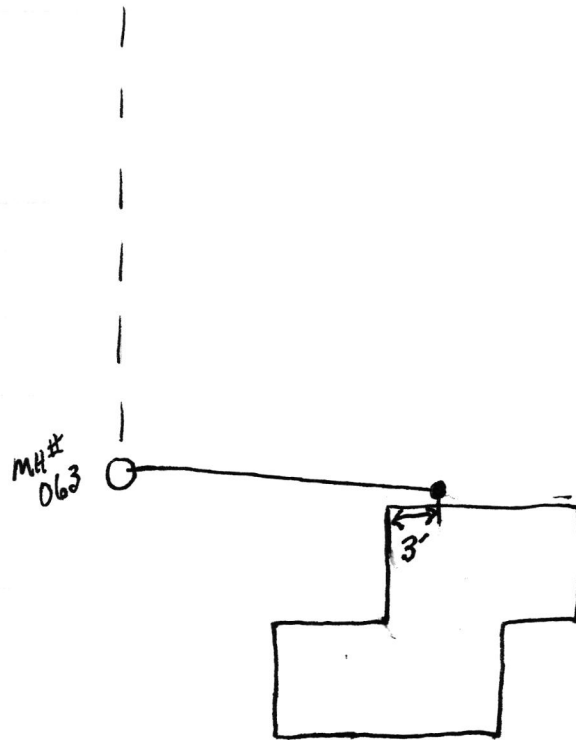

Highway 201
CH- Phase II

8-15-18

