

22-15055.60
4815

FALL CREEK REGIONAL WASTE DISTRICT

9378 S 650 WEST, P.O. BOX 59, PENDLETON, IN 46064

765-778-7544

AGREEMENT FOR SANITARY SEWER SERVICE

This Agreement made and entered into this 15th day of April, 2003, between FALL CREEK REGIONAL WASTE DISTRICT ("District") and Robert S. Taylor, Inc. ("Applicant") regarding the provision of sanitary sewer service, and the assignment of capacity in, and connection to, the District's facilities for the premises located at Lot #31 Village Colony 110 Whitehall Way

NOW THEREFORE, the parties, in consideration of the mutual promises set out in this Agreement, the receipt and sufficiency of which is hereby acknowledged, agree as follows:

1. The Applicant agrees that all workmanship and materials shall conform to all District ordinances and the District's construction standards. District must accept and approve all work and materials before backfilling and final connection is made to the sewer mains. Any violation of this provision will cause all lines and appurtenances in violation to be removed and replaced at the Applicant's expense.

2. The District shall have the right to enter upon the Applicant's premises at all reasonable times to inspect, repair, or replace any equipment used in connection with the District's service or which has an impact on said service.

3. The Applicant shall be responsible for all monthly user rates, capacity charges, and tap fees. The failure to pay any rate charge or fee may result in a lien against the property and/or the termination of service to the property, the cost of which will be borne by Applicant, including, but not limited to, all attorney's fees and collection costs.

4. The District shall not be responsible for any damages as a result of any failure to supply service unless said damages are due to default, neglect or culpability on the part of the District.

5. If there is an available sanitary sewer within three hundred (300) feet of the property line, the property owner shall be required to connect to the District's sanitary sewer system.

6. The Applicant and District agree that the provision of sanitary sewer service touches and concerns the property and the terms of this Agreement bind the District and Applicant and their heirs, executors, administrators, personal representatives, successors, agents, attorneys, assigns, designees, and transferees.

The parties hereto have read and fully understand the above provisions and agree to comply with said provisions.

FALL CREEK REGIONAL WASTE DISTRICT

APPLICANT

Signature

Signature

STATE OF INDIANA)
) SS:
COUNTY OF MADISON)

SUBSCRIBED and sworn to before me this _____ day of _____, 200__.

My Commission Expires:

Signature _____

Printed _____

Notary Public
Resident of Madison County

INSPECTOR Ben DATE INSPECTED 6-2-03 APPROVED ✓ REJECTED _____

REASON FOR REJECTION _____

DATE REINSPECTED _____ APPROVED _____ REJECTED _____

NOTES:

SIZE PIPE 6 TYPE PIPE PVC

BASEMENT YES NO ✓

SUMP PUMP YES NO ✓

DOWNSPOUT TO GROUND YES ✓ NO


SEPTIC TANK PUMPED & FILLED YES NO ✓

CONTRACTOR Don Brown

SPECIAL CONDITIONS _____

EXISTING HOME _____

NEW CONSTRUCTION ✓

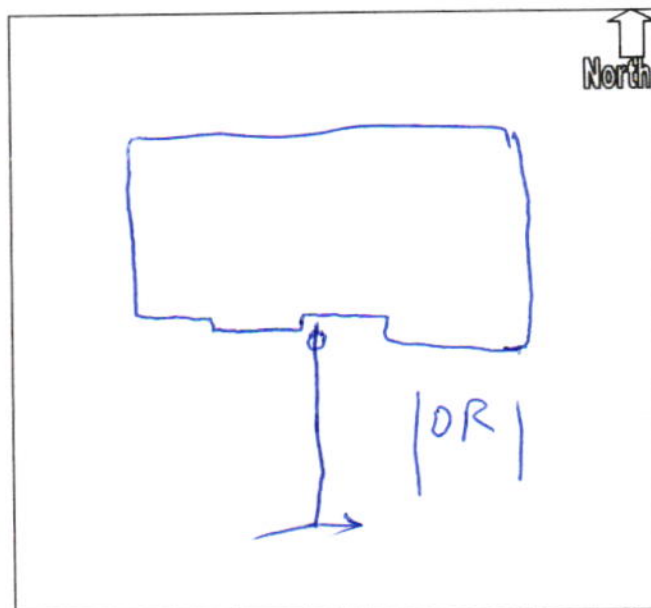

VENDOR ID FALLCREE		NUMBER 00001268		DATE 04/14/03	
PAYEE Fall Creek Regional Waste Dist		MEMO			
INVOICE NUMBER	INVOICE DATE	INVOICE AMOUNT	PREVIOUS PAY/CREDIT	DISCOUNT TAKEN	AMOUNT OF PAYMENT
	lot # 31 Village Colony Anderson				
				TOTAL	*****\$2,635.00



ROBERT G. TAYLOR, INC.
8880 SOUTH CR. 800 WEST
DALEVILLE, IN 47334

FIRST MERCHANTS BANK, N.A.
MUNCIE, INDIANA
71-65/749

1269

00001268

PAY TWO THOUSAND SIX HUNDRED THIRTY-FIVE AND XX / ~~100~~ ^{DATE} Dollars AMOUNT

04/14/03 *****\$2,635.00

TO THE
ORDER
OF

Fall Creek Regional Waste Dist
P.O. Box 59
Pendleton, IN 46064

ROBERT G. TAYLOR, INC.

Cindy L. Costen ^{MP}
AUTHORIZED SIGNATURE

⑈001269⑈ ⑆074900657⑆