Fall Creek Regional Waste District 9378 S 650 W, P.O. Box 59, Pendleton, IN 46064 765-778-7544

## Agreement for Sanitary Sewer Service

This Agreement made and entered into this	
	endleton, til Moray
<b>Now therefore,</b> the parties, in consideration of the mutual promises set out in this Agreement, the receipt and sufficiency of which is hereby acknowledged, agree as follows:	
<ol> <li>The Applicant agrees that all workmanship and materials shall conform to all District ordinances and the District's construction standards. District must accept and approve all work and materials before backfilling and final connection is made to the sewer mains. Any violation of this provision will cause all lines and appurtenances in violation to be removed and replaced at the Applicant's expense.</li> <li>The District shall have the right to enter upon the Applicant's premises at all reasonable times to inspect, repair, or replace any equipment used in connection with the District's service or which has an impact on said service.</li> <li>The Applicant shall be responsible for all monthly user rates, capacity charges, and tap fees. The failure to pay any rate charge or fee may result in a lien against the property and/or the termination of service to the property, the cost of which will be borne by Applicant, including, but not limited to, all attorney's fees and collection costs.</li> <li>The District shall not be responsible for any damages as a result of any failure to supply service unless said damages are due to default, neglect or culpability on the part of the District.</li> <li>If there is an available sanitary sewer within three hundred (300) feet of the property line, the property owner shall be required to connect to the District's sanitary sewer service touches and concerns the property and the terms of this Agreement bind the District and Applicant and their heirs, executors, administrators, personal representatives, successors, agents, attorneys, assigns, designees, and transferees.</li> </ol>	
The parties hereto have read and fully understand the above provisions.  FALL CREEK REGIONAL WASTE DISTRICT	
FALL CREEK REGIONAL WASTE DISTRICT Signature	APPLICANT Signature
STATE OF INDIANA )	
) SS: COUNTY OF MADISON )	
	May, 20 20 Roche E. Honor ochel E. Anderson otary Public esident of fradace County
	~ ~ ~ ~ ~ ~ ~ ~ ~ ~ ~ ~ ~ ~ ~ ~ ~ ~ ~ ~
Inspector Down Date Inspected 79-20 Approved_	Rejected
Reason for Rejecton Approved Notes: / Notes: /	Rejected
Reason for Rejecton Date Reinspected Approved	
Reason for Rejecton Date Reinspected Approved  Notes: 5	Rejected
Reason for Rejecton	Rejected
Reason for Rejecton	Rejected

## STOEPPELWERTH

CONTROL# 91616 WEST

JOB ID CARG1A.37

7965 East 106th Street, Fishers, IN 46038-2505 phone: 317.849.5935 fax: 317.849.5942

70.4

72.2

12.8

COMMON AREA #3 VAR. D.U.&L.M.A.E.

12.00

PATIO

48.00

MODEL= MCKINLEY CARRIAGE F.F.ELEV.= 873.20 (SLAB) (RH)

GAR. 872.53

5'SW

5'SW

~

α

70,

70.4

15' D.&U.E.

72.2

72.2

25' G.B.L

15' D. &U.E.

20' B.L.

PORCH

26.0'

35.39

71.2

70.6

SOD LINE -

03 39. 10.0 111 CARRICK GLEN BOULEVARD PENDLETON, IN 46064

CONTRACTOR SHALL CUT 10' OFF OF LATERAL AND BEGIN FROM THAT POINT AND CONNECT TO HOUSE FOLLOWING PLOT PLAN. LAKE #1 N.P. ELEV.=864.74 100 YEAR ELEV.=868.13

1" = 30'LOT AREA: 9,668 Sq. Ft.

LOT COVERAGE=19.6% M.L.A.G.=872.2 M.F.F.=872.7

LEGEND: XX.XAB

PROPOSED GRADE PER PLAN

AS BUILT GRADE

PSL W W

S.S.D.

SUB-SURFACE DRAIN SANITARY SEWER
6" AS BUILT SANITARY LATERAL
6" PROPOSED SANITARY LATERAL

STORM SEWER 3/4" WATER CONNECTION WATER MAIN

SWALE

SANITARY MANHOLE

STORM MANHOLE

CURB INLET

FIRE HYDRANT

WATER METER

D.U.&L.M.A.E. DRAINAGE, UTILITY & LANDSCAPE, MAINTENANCE ACCESS EASEMENT

D.&U.E. B.L. G.B.L. VAR. M.L.A.G.

M.F.F.

ACCESS EASEMENT
DRAINAGE & UTILITY EASEMENT
BUILDING LINE
GARGE BUILDING LINE
VARIABLE
MINIMUM LOWEST ADJACENT

GRADE MINIMUM FINISHED FLOOR

CARRICK & **GLEN** BOULEVARD

5'SW 168'±

T.C.=871.10 ±

50,00

5.0

5'SW

LIFT STATION LOT 37 CARRICK GLEN

SECTION 1A INST. #(UNRECORDED) ZONING: SINGLE FAMILY

5' MINIMUM SIDE YARD 15' MINIMUM REAR YARD

50% MAXIMUM LOT COVERAGE
THIS PLOT PLAN WAS PREPARED FROM AN UNRECORDED PLAT AND IS SUBJECT TO CHANGE.

BENCHMARK TOP OF CURB=871.11

SOD LINE

71.3

71.11

71.14

71.6

ALL UNDERGROUND SEWERS AND UTILITIES SHOWN ARE PLOTTED BY SCALE FROM DESIGN PLANS FURNISHED BY ENGINEER THE ACTUAL FIELD LOCATION MAY VARY.

SOD: SEEDING: CONC. DRIVEWAY:


PRIVATE WALK:

**PUBLIC WALK:** 

 $2,868 \pm \text{ Sq. Ft.}$  $5,065 \pm \text{ Sq. Ft.}$ N/A ± Sq. Ft. 450 ± Sq. Ft. 459 ± Sq. Ft.

No. STATE OF WOIANA SURVENIENT SURVENIENT NOTE: THIS DRAWING IS NOT INTENDED TO BE REPRESENTED AS A RETRACEMENT OR ORIGINAL BOUNDARY SURVEY, A ROUTE SURVEY OR A SURVEYOR LOCATION REPORT.



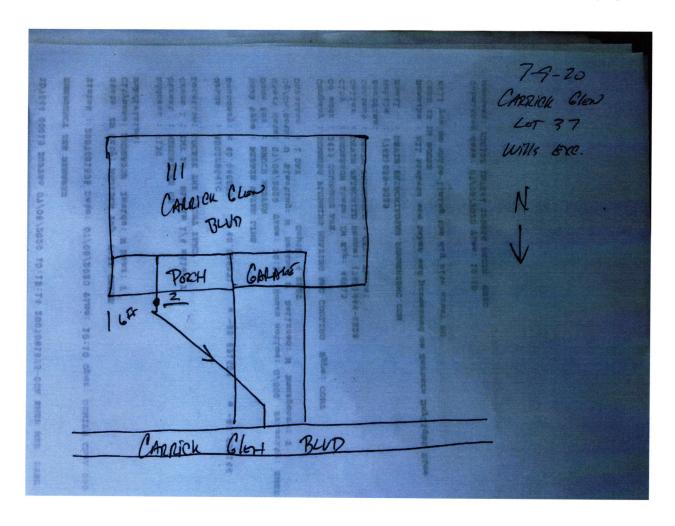





FALL CREEK REGIONAL WASTE DISTRI 9378 S 650 W PO BOX 59 PENDLETON, IN 46064 765-778-7544

FALL CREEK REGIONAL WASTE DIST 0005560008022120839000

Date: 04/07/2020

01:48:20 PM

CREDIT CARD SALE

**MASTERCARD** 

CARD NUMBER:

\*\*\*\*\*\*\*\*0366 K

TOTAL AMOUNT: APPROVAL CD:

\$760.00 067807

ECI:

RECORD #:

CLERK ID:

000 Rachel

CUST CODE:

PERMIT

SALES TAX:

\$0.00

INVOICE #;


7228

D. R HORTON

I AGREE TO PAY THE ABOVE TOTAL AMOUNT ACCORDING TO THE CARD ISSUER AGREEMENT (MERCHANT AGREEMENT IF CREDIT VOUCHER)

Thank you for your business!

Merchant Copy

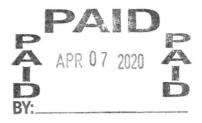

Lec# 01178