



# FALL CREEK REGIONAL WASTE DISTRICT

Box 44, Pendleton, Indiana 46064

2-0021620

Nº 000781

## APPLICATION FOR SEWER PERMIT

Permit No. \_\_\_\_\_ Date 11-25-85

Permit Void 90 days from Date of Issuance

Owner Name LOWELL R. ASHBURN

LANTERN  
MONDAYS

Property Address 111 N. FAIRFIELD LAKE

Lot # \_\_\_\_\_ P.O. Box \_\_\_\_\_

Town PENDLETON, IN Zip Code 46064

Phone 778-3801 Water Meter \_\_\_\_\_

\$ 150.00 Tap on Fee Paid

\$ 25.00 Inspection fee paid

Application is hereby made for connection to the Fall Creek Regional Waste District Sewer System for the above listed property - Permit Type: Residential ☒, Commercial \_\_\_\_\_, Industrial \_\_\_\_\_, or Governmental/Institutional \_\_\_\_\_. User Information \_\_\_\_\_.

All workmanship and materials shall conform to the standards of the District Ordinance as described in Ordinance 84-2 and 84-3 as amended. Acceptance and approval must be made by the District inspector or his duly authorized representative before backfilling and final connection is made to the main sewer lines. Any violation of applicable regulations will cause all lines and appurtenances in violation to be removed and replaced at the owners expense.

The Fall Creek Regional Waste District is responsible for the inspection, approval of materials, and installation techniques only. All costs for materials and installation and any liabilities resulting from same is the sole responsibility of the property owner.

I have read and fully understand the above provisions and agree to comply by said provisions.

Bill Ragan for Lowell Ashburn  
APPLICANT(S) SIGNATURE

\*\*\*\*\*

INSPECTOR [Signature]

Date inspected 11-27 Approved \_\_\_\_\_ Rejected \_\_\_\_\_

Reason for rejection \_\_\_\_\_

Date reinspected \_\_\_\_\_ Approved \_\_\_\_\_ Rejected \_\_\_\_\_

Notes:

Size Pipe 6 "

Type Pipe PVC

Basement Yes \_\_\_\_\_ No ☒


Sump Pump Yes \_\_\_\_\_ No ☒

Downspout to Ground Yes ☒ No \_\_\_\_\_

Septic Tank Pumped & filled Yes \_\_\_\_\_ No \_\_\_\_\_

Contractor PASSMORE

Special Conditions \_\_\_\_\_

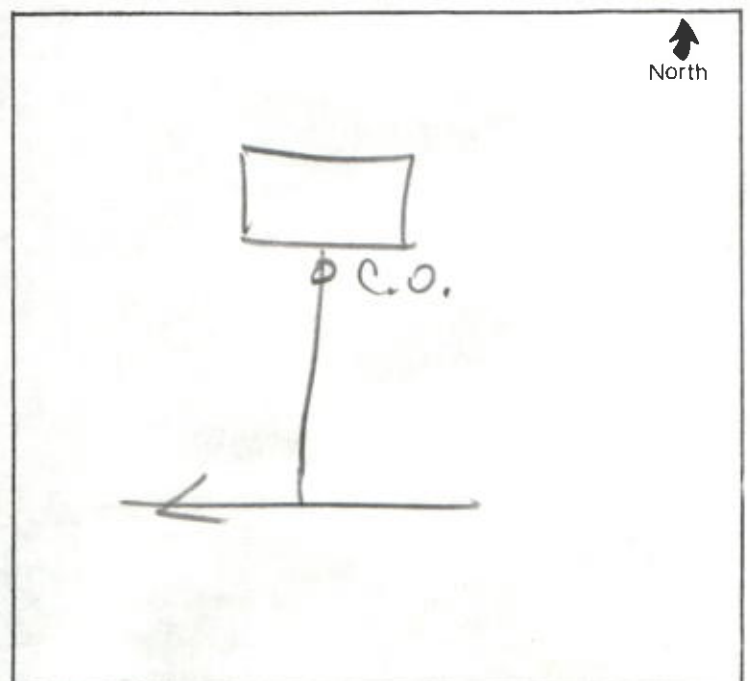

# FALL CREEK REGIONAL WASTE DISTRICT

City of Population January 2002



127608 22

11-22-82

WATER

Lower R. Ashburn

11 N. Street Ave

Pennington

120-3801

120.00

The following information was obtained from the records of the Fall Creek Regional Waste District. It is the policy of the District to maintain accurate records of all waste disposal activities. The information is provided for your information and is not to be used for any other purpose. The District is not responsible for the accuracy of the information provided.

The following information was obtained from the records of the Fall Creek Regional Waste District. It is the policy of the District to maintain accurate records of all waste disposal activities. The information is provided for your information and is not to be used for any other purpose. The District is not responsible for the accuracy of the information provided.

