



FALL CREEK REGIONAL WASTE DISTRICT

Box 44, Pendleton, Indiana 46064

22-01430.00

APPLICATION FOR SEWER PERMIT

Nº 001764

Permit No. _____ Date _____
Permit Void 90 days from Date of Issuance
Owner Name Bill Thetford
Property Address 111 W. Falcon Run
Lot # _____ P.O. Box _____
Town Pendleton, IN Zip Code 46064
Phone _____ Water Meter _____
\$ N/A Tap on Fee Paid
\$ 25.00 Inspection fee paid 12-3-90

Application is hereby made for connection to the Fall Creek Regional Waste District Sewer System for the above listed property - Permit Type: Residential X, Commercial _____, Industrial _____, or Governmental/Institutional _____. User Information _____.

All workmanship and materials shall conform to the standards of the District Ordinance as described in Ordinance 84-2 and 84-3 as amended. Acceptance and approval must be made by the District inspector or his duly authorized representative before backfilling and final connection is made to the main sewer lines. Any violation of applicable regulations will cause all lines and appurtenances in violation to be removed and replaced at the owners expense.

The Fall Creek Regional Waste District is responsible for the inspection, approval of materials, and installation techniques only. All costs for materials and installation and any liabilities resulting from same is the sole responsibility of the property owner.

I have read and fully understand the above provisions and agree to comply by said provisions.

APPLICANT(S) SIGNATURE

INSPECTOR Tim

Date inspected 9/90 Approved ✓ Rejected _____

Reason for rejection _____

Date reinspected _____ Approved _____ Rejected _____

Notes:

Size Pipe 6"

Type Pipe PVC

Basement Yes _____ No ✓


Sump Pump Yes _____ No ✓

Downspout to Ground Yes ✓ No _____

Septic Tank Pumped & filled Yes _____ No ✓

Contractor SELF (GREIG)

Special Conditions SON

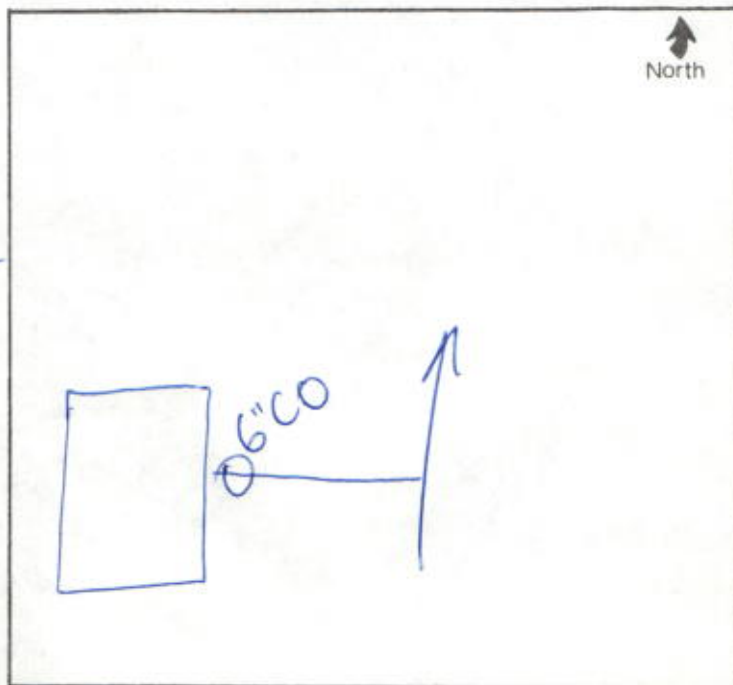



FALL CREEK REGIONAL WASTE DISTRICT

P.O. Box 59 • 9378 S. 650 West • Pendleton, Indiana 46064-0059 • (317) 778-3983

November 20, 1990

Bill Thetford
111 W Falcon Run
Pendleton, IN 46064

RE: Inspection Fee

Dear Mr. Thetford:

According to our records the tap-on fee was a condition of the R/W purchase, however, the \$25.00 inspection fee for your property has not been paid. Your permit indicates that the connection was made in September 1990. The inspection fee was due prior to connection.

Please consider this a request for payment due upon receipt of this letter. If your records show payment was made or if you should have any questions please contact our office.

Respectfully,

Dod Nobel
General Manager

tas