




Oak ST Apartments

Don 8/12/14/17

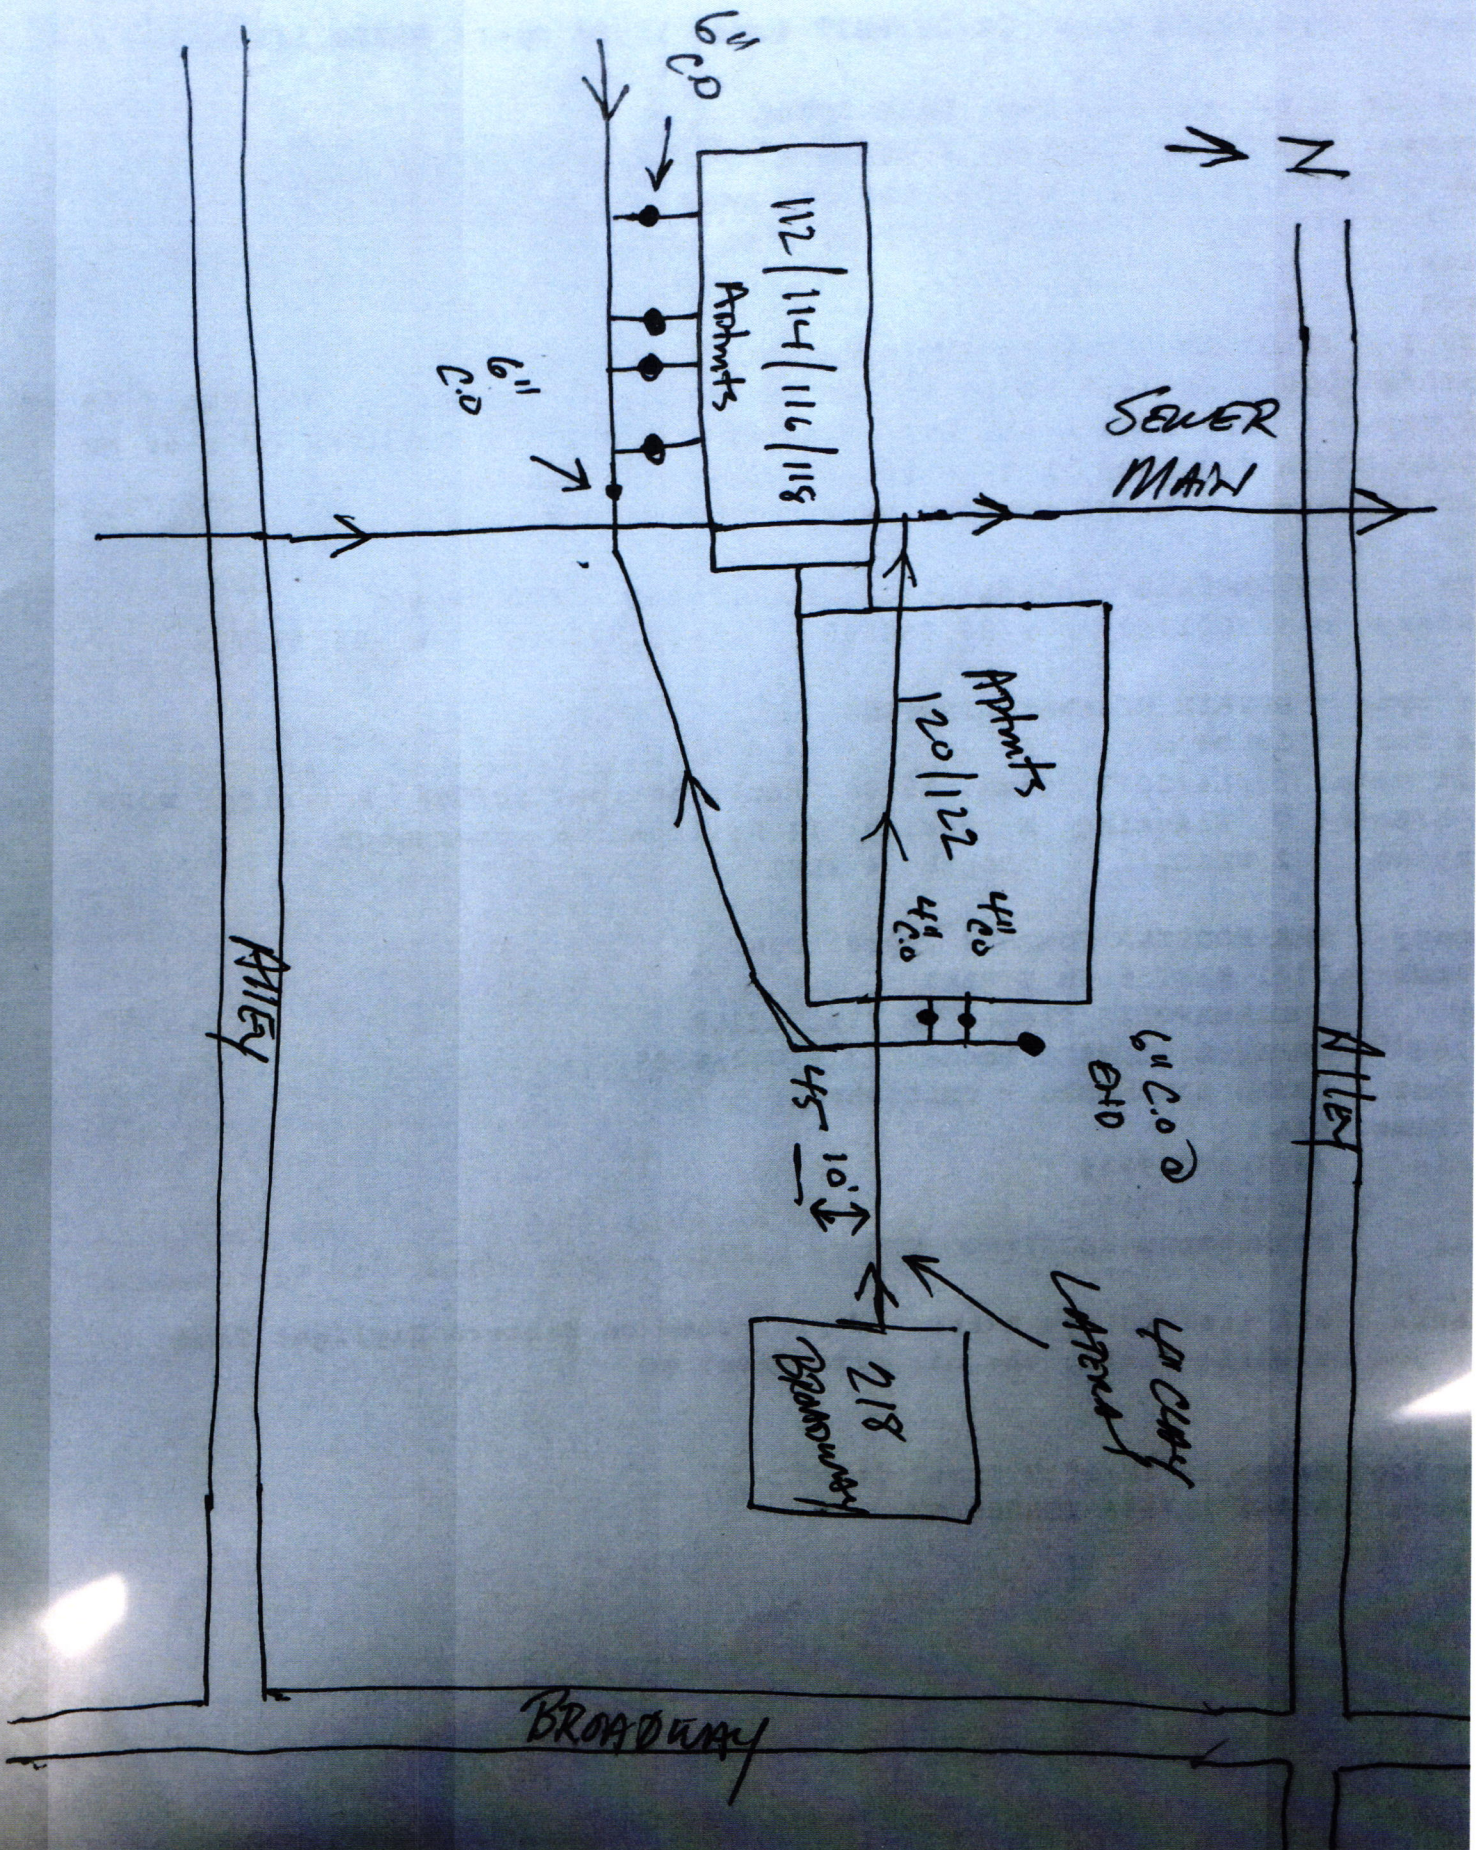

5

Dak St Apartments

Don

12.14.17

APT M+
120/122

N

