

Gidw.

PROJECT Phase II. SHEET _____ OF _____


SUBJECT _____ DATE 5-14-18

JOB NO. 4447

BY Atlas

114 S. Main

← N

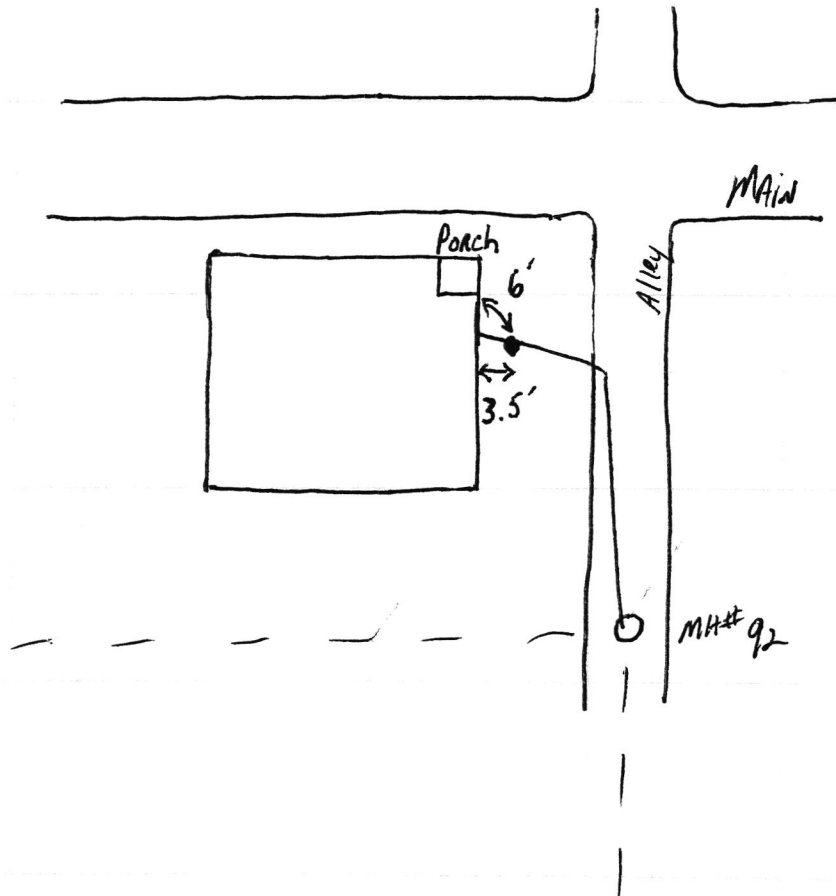

11a-114 S Main

Sgt Phase II

5.22.18

