

Gidw.

PROJECT Phase II SHEET _____ OF _____


SUBJECT _____ DATE 8-1-18

JOB NO. 4447

BY Atlas

112 E. High

N →

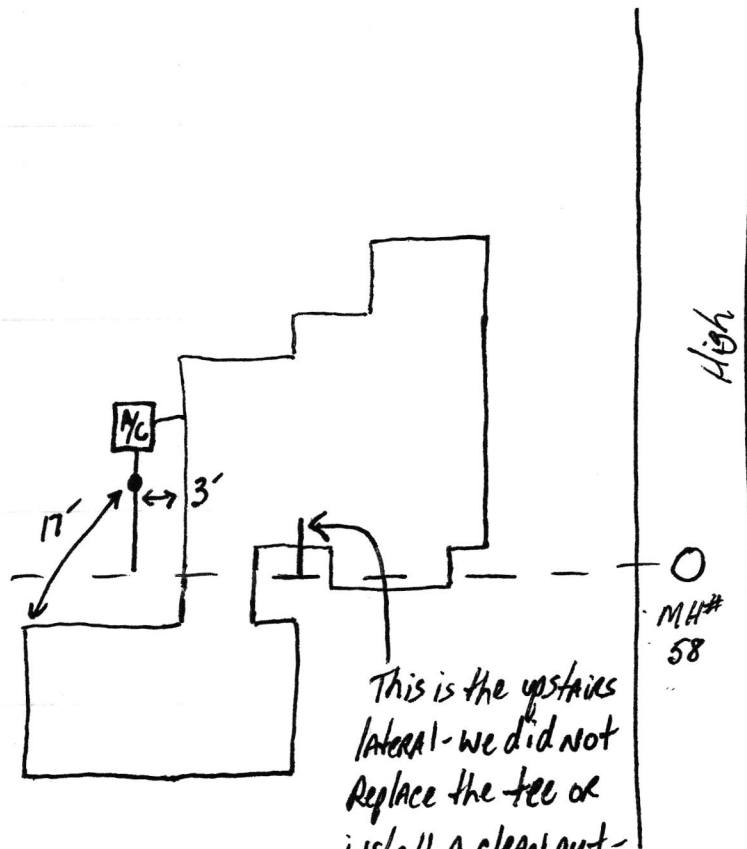

This is the upstairs lateral - we did not replace the tee or install a clean out - too close to the foundation - there is an "X" scored in the concrete



ONT RMSE II

8-15-18