

G.R.W.

PROJECT Phase II


SHEET _____ OF _____

SUBJECT _____

DATE 6-25-18

JOB NO 4447

BY Atlas

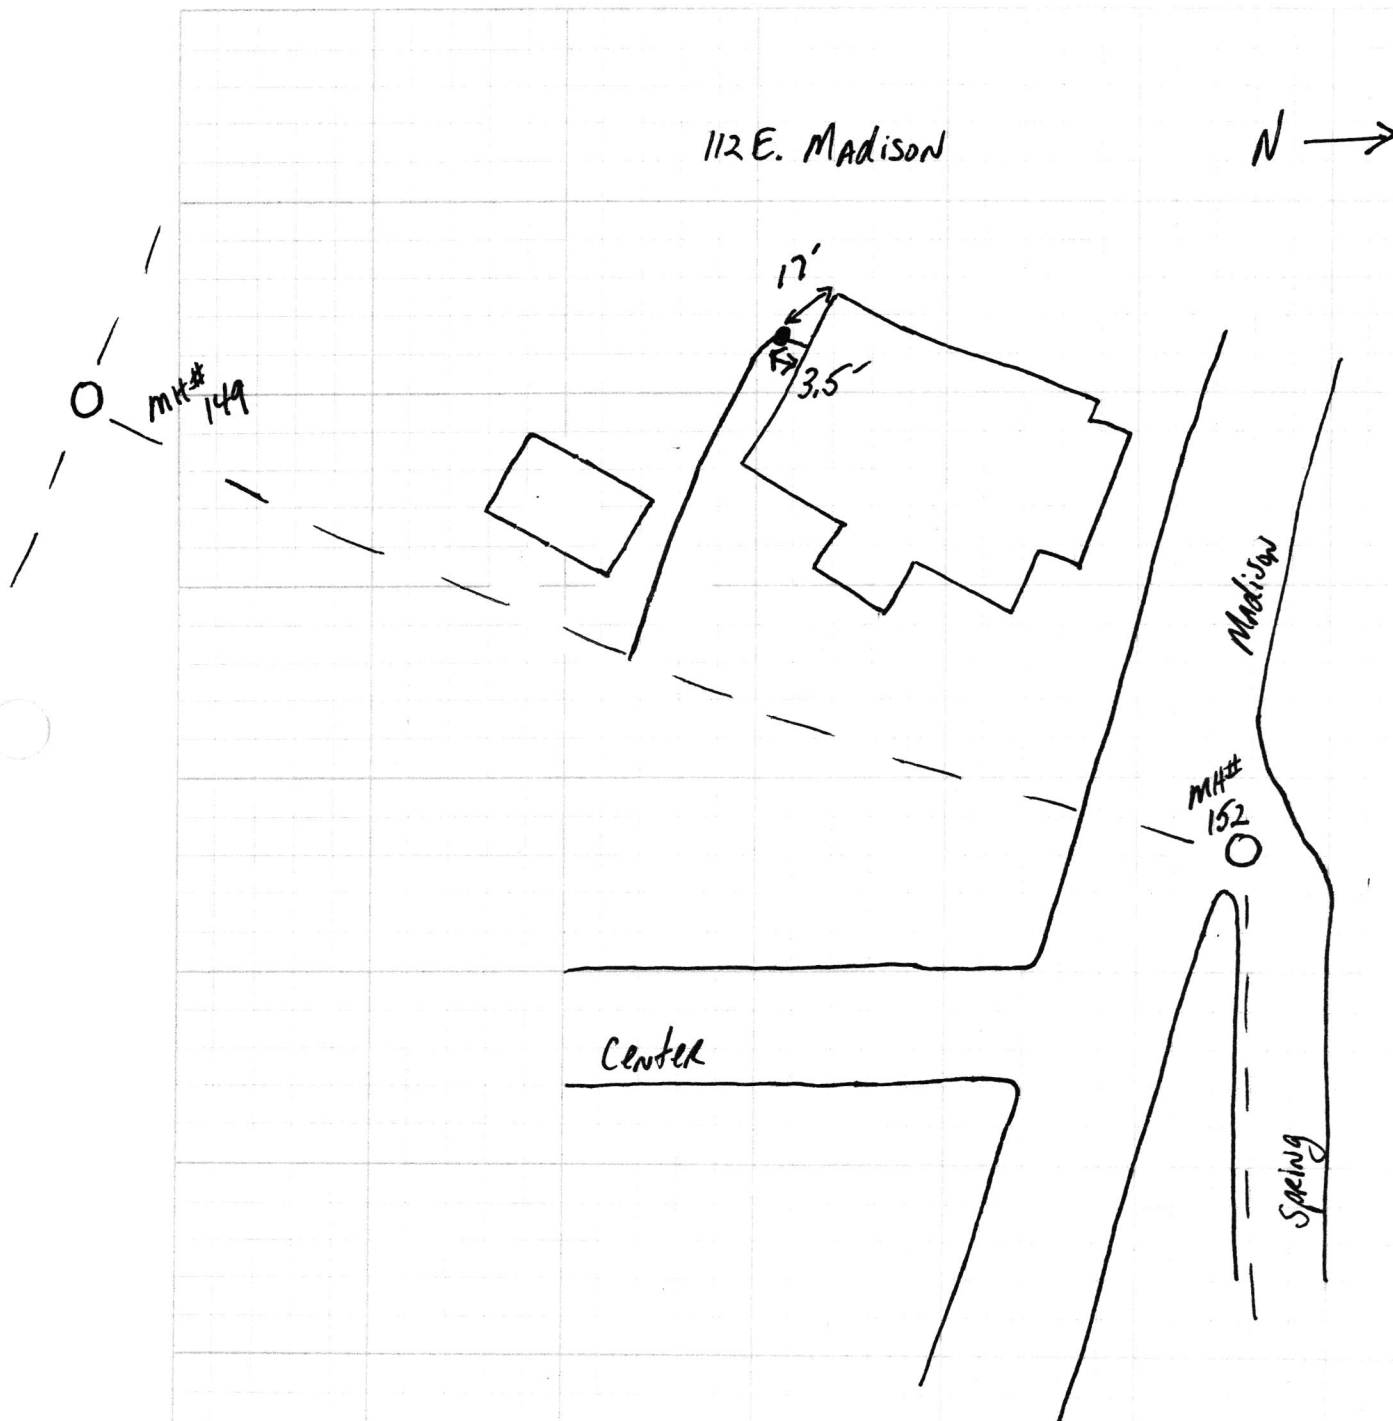



U.S. 18

SKT Phase II

UNION