

Gidw.


PROJECT Phase II SHEET _____ OF _____

SUBJECT _____ DATE 5-8-18

JOB NO. 4447

BY ALAS

112 Franklin

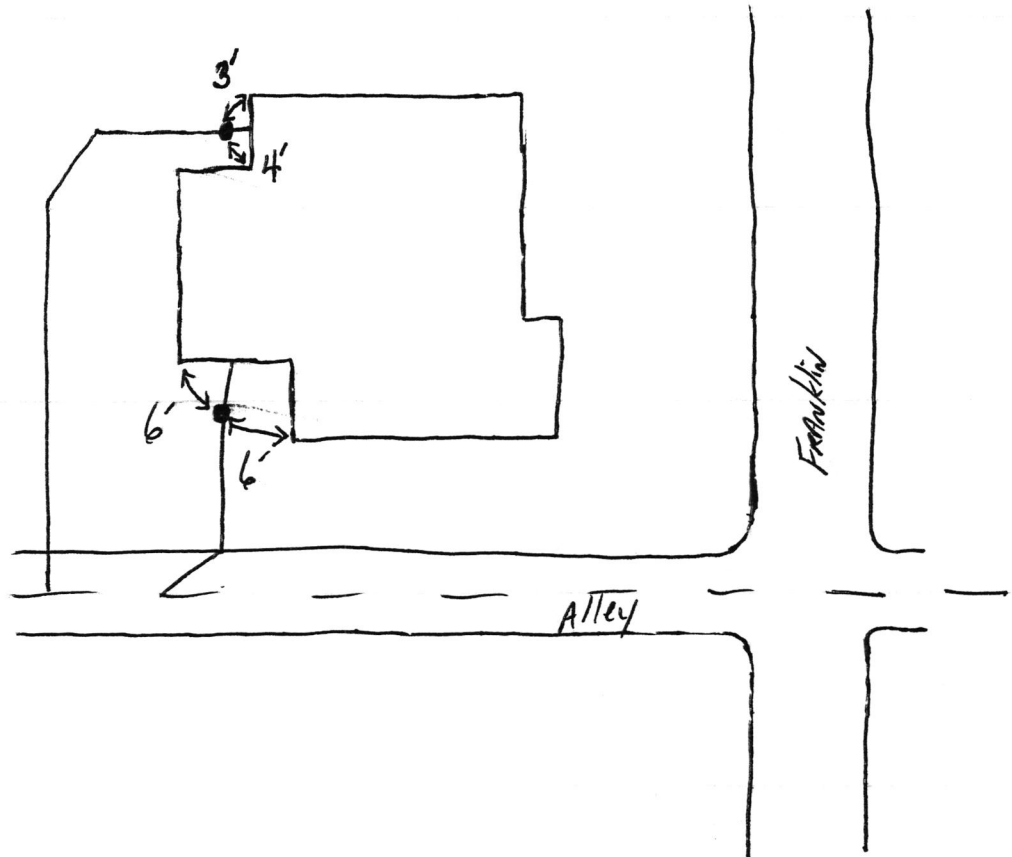

11a Franklin

S&C Phase II

5-14-18



5.14.18

SRF Phase II

112 Franklin

