


Gidw.

PROJECT Phase II SHEET \_\_\_\_\_ OF \_\_\_\_\_  
SUBJECT \_\_\_\_\_ DATE 6-15-18  
JOB NO. 4447  
BY Atlas

112 E. INDIANA

N  
↓

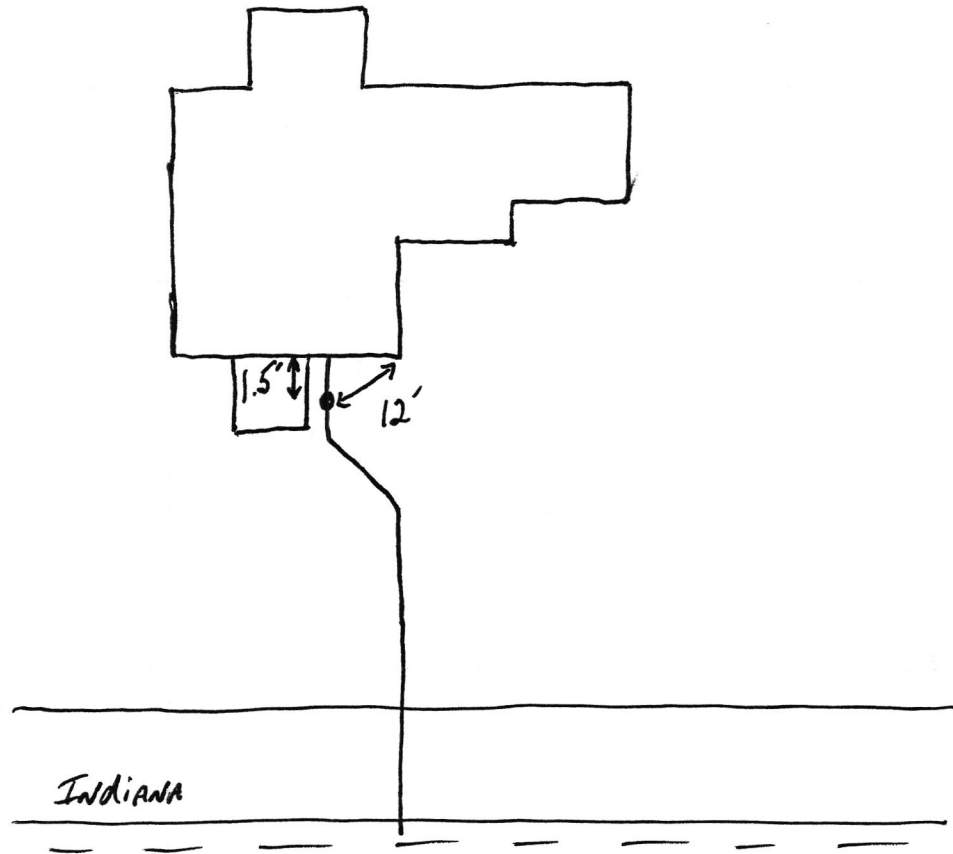

11a Indiana

SRF Phase II

6.19.18

