

add order
on file



FALL CREEK REGIONAL WASTE DISTRICT

9378 S. 650 West PO Box 59
Pendleton, IN 46064-0059 778-7544

21-03415.00

Nº 2678

APPLICATION FOR SEWER PERMIT

Date 5-3-99

Permit Void 90 days from Date of Issuance

Owner Name Southgate Homes

Property Address 112 Leatic Way

Lot # 47 P.O. Box _____

Town Ingalls, IN Zip Code 46048

Phone 641-7018 City Water ☒ Well _____

\$ 700.00 Tap on Fee Paid

\$ _____ ~~Inspection fee paid~~

Application is hereby made for connection to the Fall Creek Regional Waste District Sewer System for the above listed property - Permit Type: Residential _____, Commercial _____, Industrial _____, or Governmental/Institutional _____. User Information _____.

All workmanship and materials shall conform to the standards of the District Ordinance as described in Ordinance 84-2 and 84-3 as amended. Acceptance and approval must be made by the District inspector or his duly authorized representative before backfilling and final connection is made to the main sewer lines. Any violation of applicable regulations will cause all lines and appurtenances in violation to be removed and replaced at the owners expense.

The Fall Creek Regional Waste District is responsible for the inspection, approval of materials, and installation techniques only. All costs for materials and installation and any liabilities resulting from same is the sole responsibility of the property owner.

I have read and fully understand the above provisions and agree to comply by said provisions.

Frank Fought Southgate Homes
APPLICANT(S) SIGNATURE


INSPECTOR Don / Ben
Date inspected Aug 99 Approved J Rejected _____

Reason for rejection _____

Date reinspected _____ Approved _____ Rejected _____

Notes:
Size Pipe 6 "
Type Pipe PVC
Basement Yes _____ No ☒
Sump Pump Yes _____ No ☒
Downspout to Ground Yes ☒ No _____
Septic Tank Pumped & filled Yes _____ No ☒
Contractor ATA
Special Conditions _____

Existing Home _____
New Construction ☒

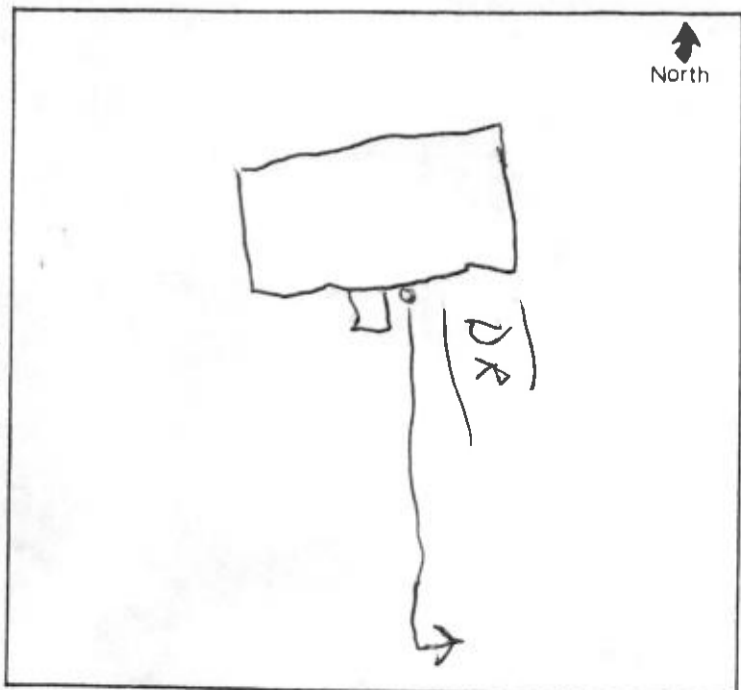

North



FALL CREEK REGIONAL WASTE DISTRICT
 9118 N. 230 WEST RD BOX 89
 TONORRHO, ID 83251-0089

81-03412-00

IN 2878


DATE: 2-3-90

Project Name: 2007/1 date from
 Property Address: 115 1st St
 Lot: 41
 Town: 2007/1
 Phone: 841-1018
 City: 2007
 State: 2007
 Zip: 2007

Application for permit to construct a new solid waste landfill...
 The applicant is requesting a permit to construct a new solid waste landfill...
 The landfill will be located on the east side of the town of 2007/1...
 The landfill will be used for the disposal of solid waste...
 The landfill will be constructed in accordance with the requirements of the...
 The landfill will be constructed in accordance with the requirements of the...

Signature: [Signature]
 Title: [Title]

Signature: [Signature]
 Title: [Title]

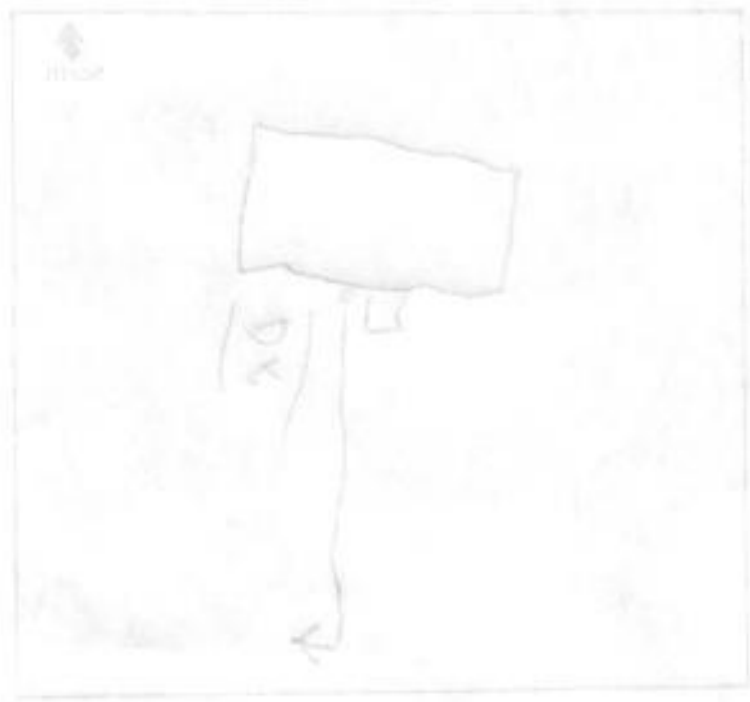

Site Map: 2007/1
 Scale: 1 inch = 100 feet
 North Arrow: [Arrow]
 Contour: 2007/1
 Elevation: 2007/1
 Area: 2007/1
 Volume: 2007/1