



FALL CREEK REGIONAL WASTE DISTRICT

9378 S. 650 West PO Box 59
Pendleton, IN 46064-0059 778-7544

Rehab

APPLICATION FOR SEWER PERMIT

-No 2746-

Date 4-4-2000

Permit Void 90 days from Date of Issuance

Owner Name

Property Address 112 EAST OAK STREET

Lot # P.O. Box

Town Pendleton, IN Zip Code 46064

Phone City Water Well

\$ N/A Tap on Fee Paid

\$ N/A Inspection fee paid

lateral replacement

Application is hereby made for connection to the Fall Creek Regional Waste District Sewer System for the above listed property - Permit Type: Residential, Commercial, Industrial, or Governmental/Institutional. User Information

All workmanship and materials shall conform to the standards of the District Ordinance as described in Ordinance 84-2 and 84-3 as amended. Acceptance and approval must be made by the District inspector or his duly authorized representative before backfilling and final connection is made to the main sewer lines. Any violation of applicable regulations will cause all lines and appurtenances in violation to be removed and replaced at the owners expense.

The Fall Creek Regional Waste District is responsible for the inspection, approval of materials, and installation techniques only. All costs for materials and installation and any liabilities resulting from same is the sole responsibility of the property owner.

I have read and fully understand the above provisions and agree to comply by said provisions.

APPLICANT(S) SIGNATURE

INSPECTOR B

Date inspected 3-30-00 Approved Rejected

Reason for rejection

Date reinspected Approved Rejected

Notes:

Size Pipe 6"

Type Pipe PVC

Basement Yes No X

Sump Pump Yes No X

Downspout to Ground Yes X No


Septic Tank Pumped & filled Yes No X

Contractor TED

Special Conditions

Existing Home

New Construction

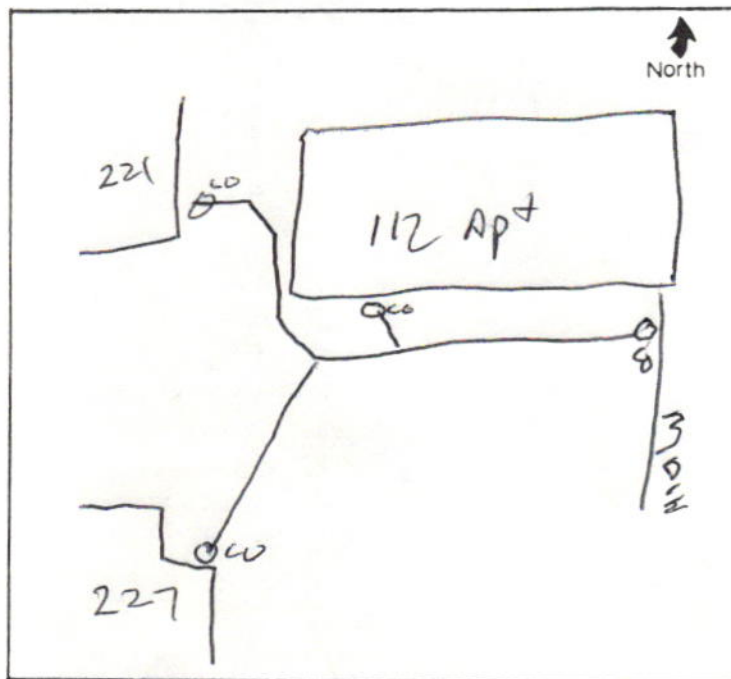

Dale ST Apartments

Don

8 12, 14, 17



Dak St Apartments

Don

12.14.17

APT M+
120/122

N



Main line Oak ST

11.27.17

Tim
McCurdy



112 Oak ST

11.27.17

Tim
McLurdy



114 & 116 Oak ST

11.27.17


Tim
McLurdy



118 Oak ST

11.27.17

Tim
McCurdy

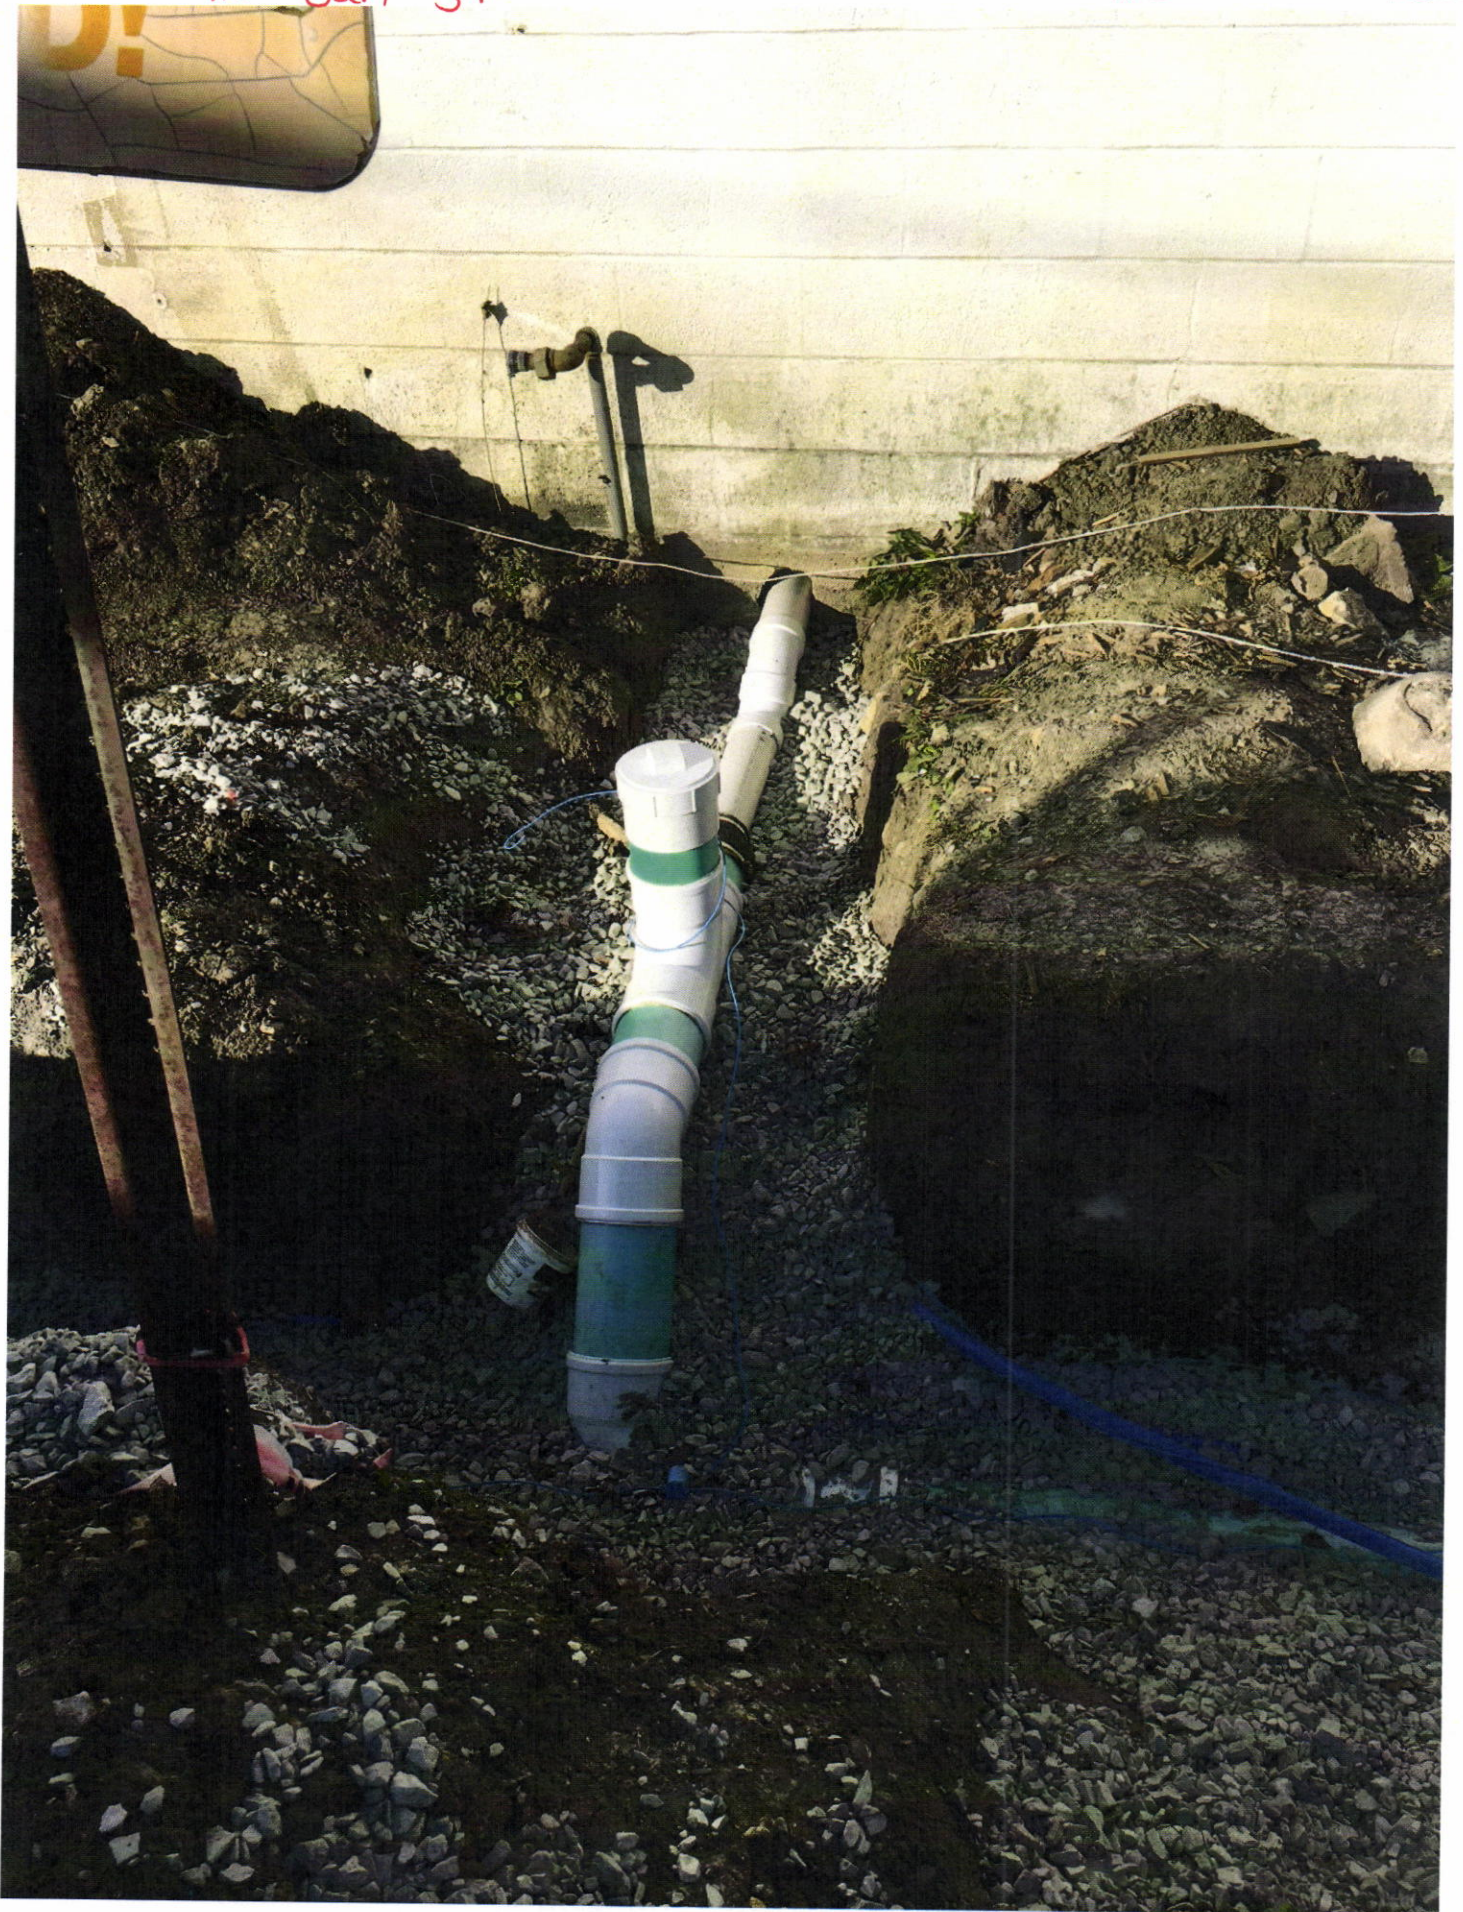

120, 122 Oak ST Tap (turned to east)

will be

11.27.17

Tim
McLurdy



Gidw.

PROJECT

Phase II

SHEET ____ OF ____

SUBJECT


DATE

JOB NO. 4447

BY Ring Bros.

Ring Const. offices & Apts.

N →

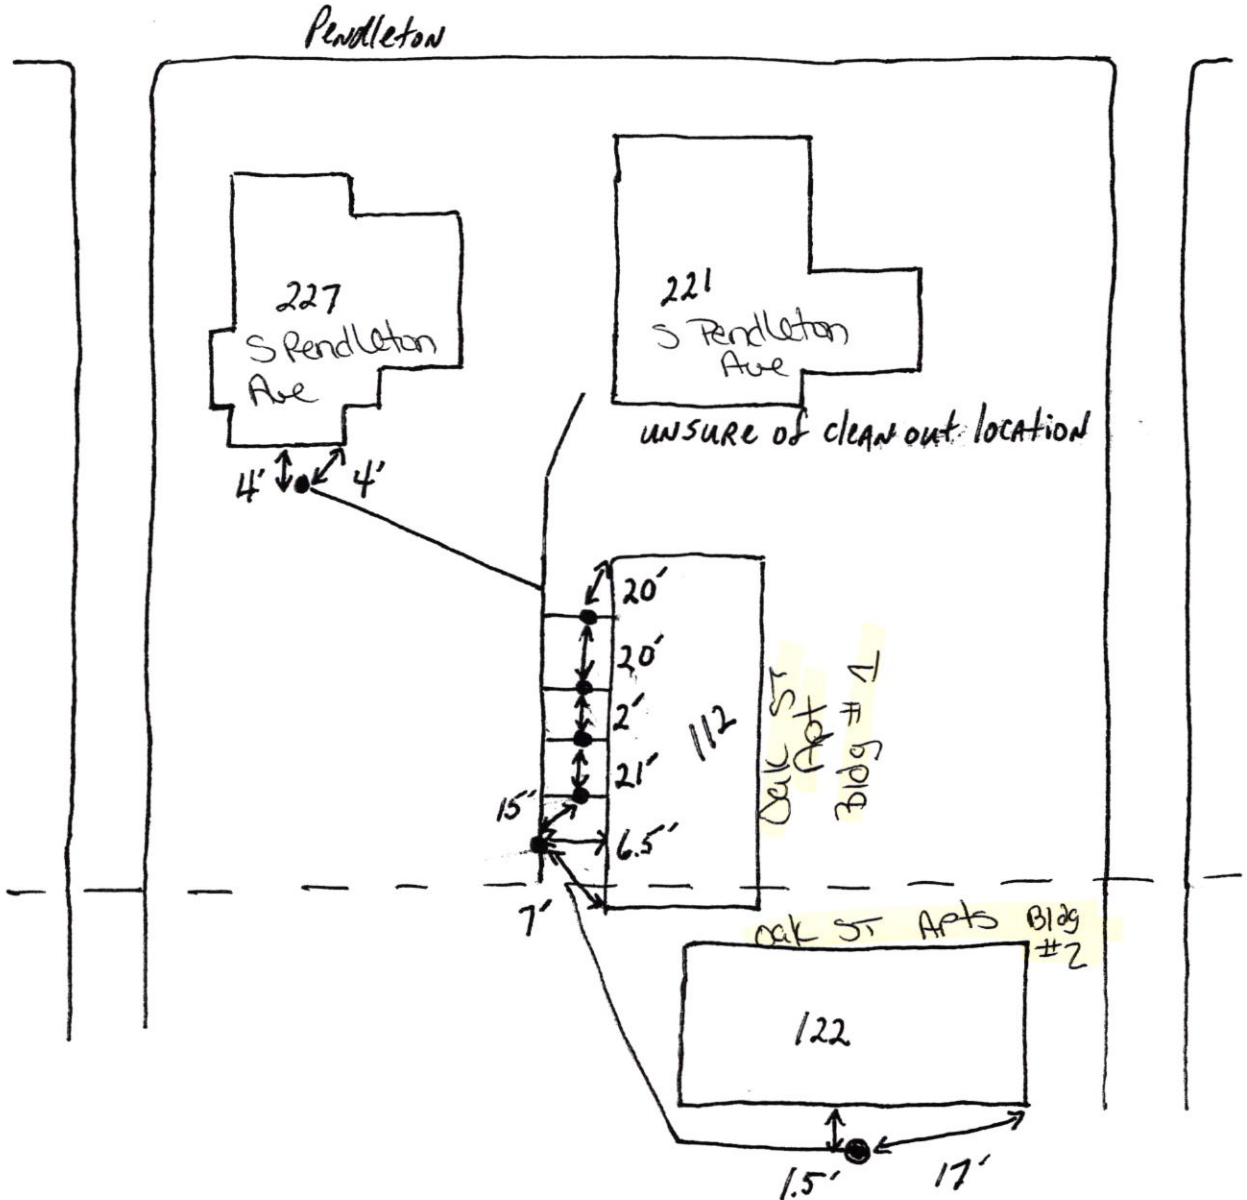

* This work was completed by Ring Const.

11a Bldg 04th ST Apt

SAC Phase II

6-21-18



1aa Bldg Oak ST Apt

SRT Phase II

6.21.18



Gidw.

PROJECT Ring Investments
SUBJECT Lateral

SHEET OF
DATE 12-4-17
JOB NO.
BY

